


T. 29 S. R. 4 W. W.M.

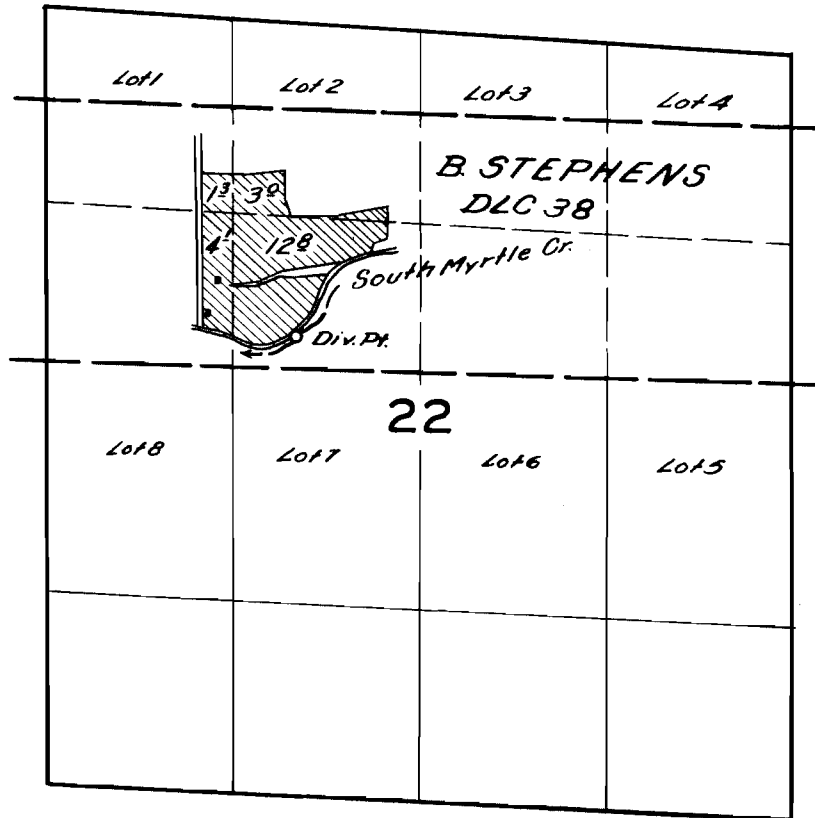

**FINAL PROOF SURVEY**

UNDER

Application No. 27512 Permit No. 21674

IN NAME OF

R. D. McMURRY

Surveyed Sept. 27 1956, by