


T.4 N.R.5 W.W.M.

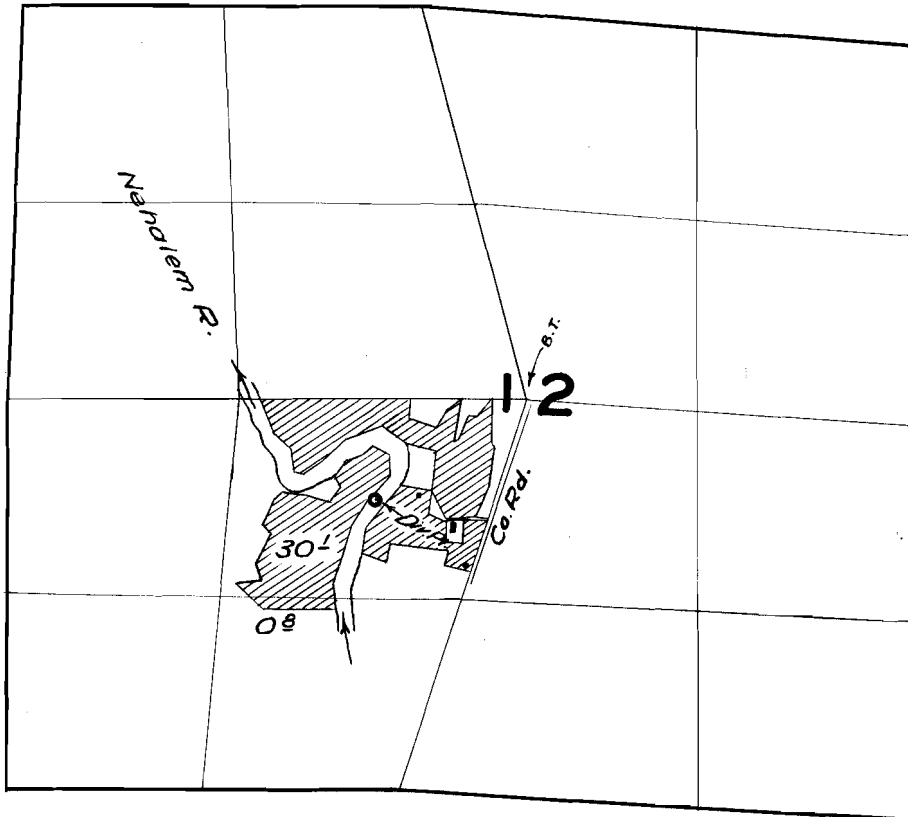

FINAL PROOF SURVEY
UNDER

Application No. 27541 Permit No. 21695
IN NAME OF

OSCAR & OREN Weed

Surveyed 11 Sept. 1959 by R.H. Whitby