


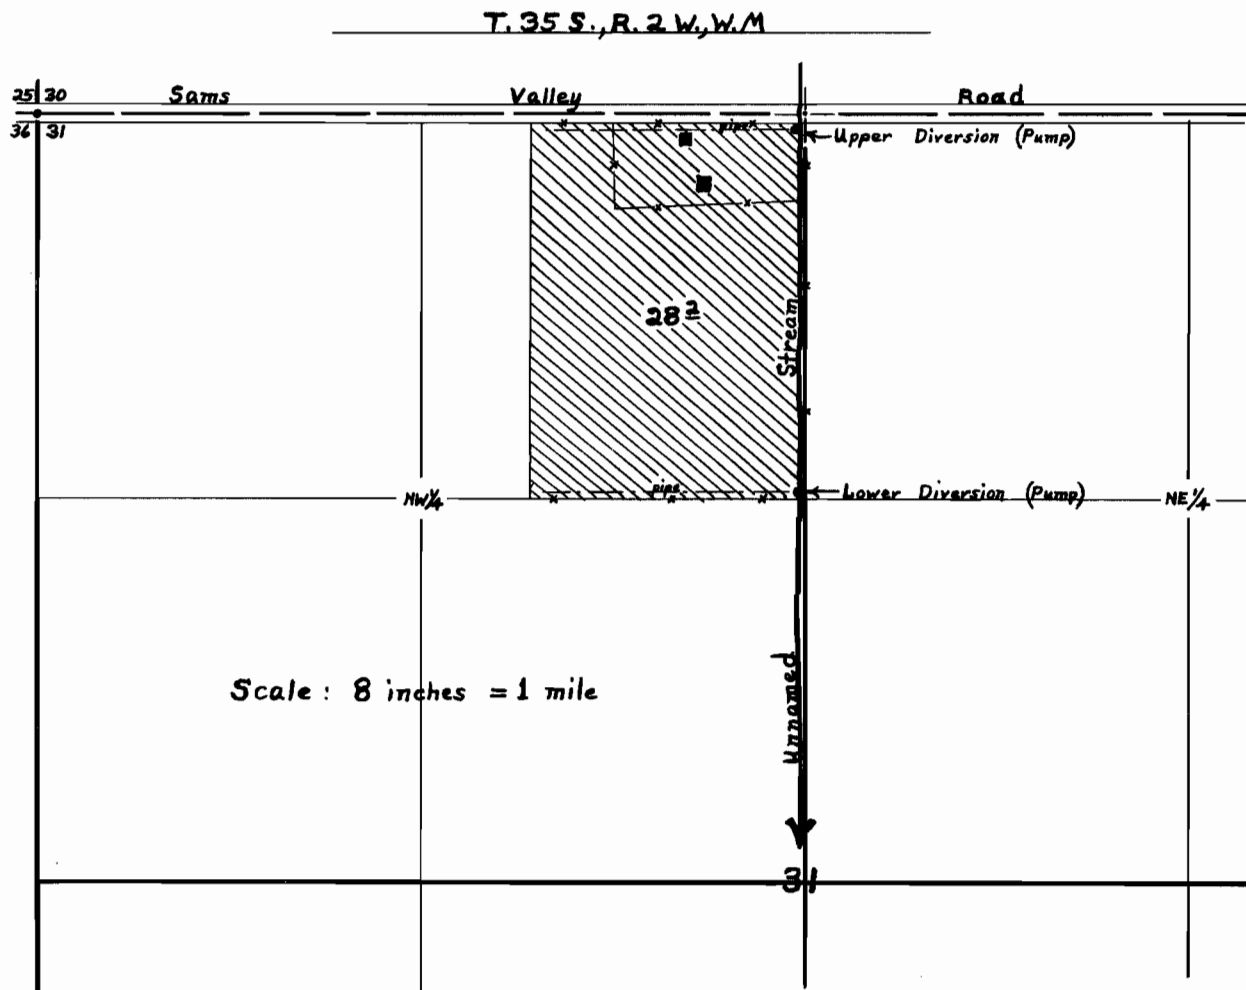

FINAL PROOF SURVEY UNDER

Application No. 28237.... Permit No. 22209....
IN NAME OF

H. A. Davidson

Surveyed March 26, 1957, by D.C. Hendrix, W.M.