


T. 6 N. R. 2 W. W. M.

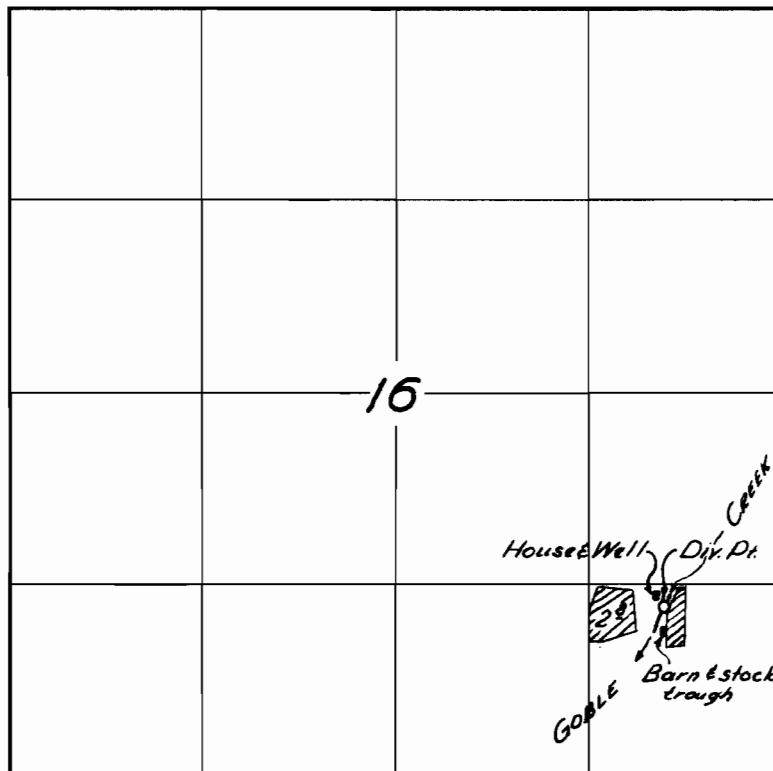

FINAL PROOF SURVEY

UNDER

Application No. 28685 Permit No. 22586

IN NAME OF

HERMAN G. & RENA HECKATHORN

Surveyed 8 Aug. 1956, by P. D. Hilby