


T.3 S. R. 2W.W.M.

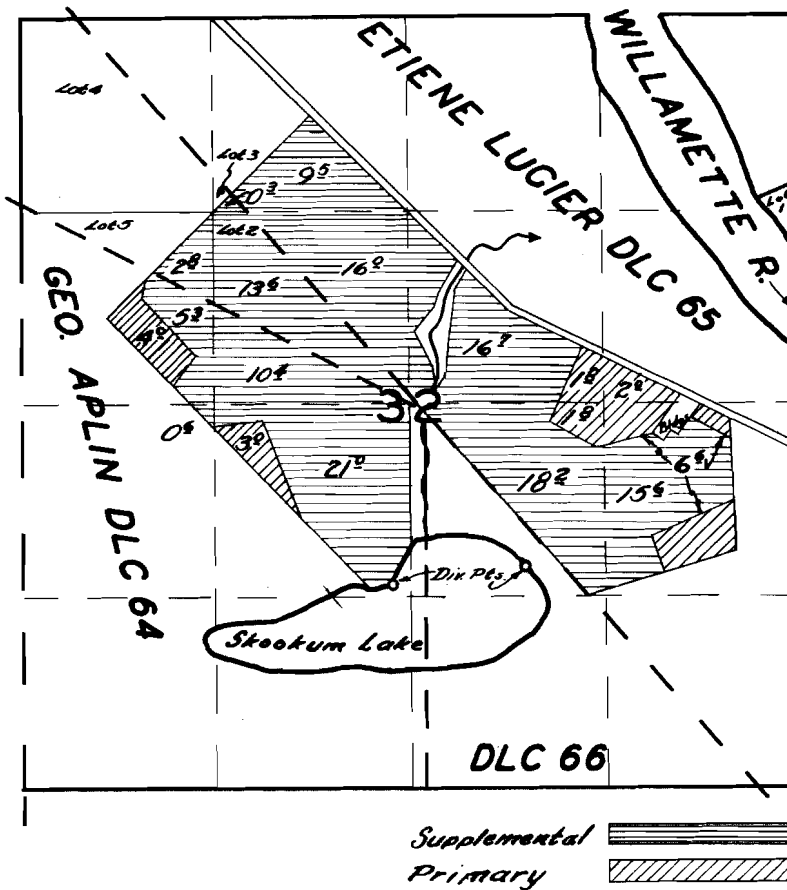

FINAL PROOF SURVEY

UNDER

Application No. 29060 Permit No. 22856

IN NAME OF

MARGARET HILLER SPROGIS

Surveyed MARCH 1957, by C.D. Bault