


T. 5 S. R. 1 W.W.M.

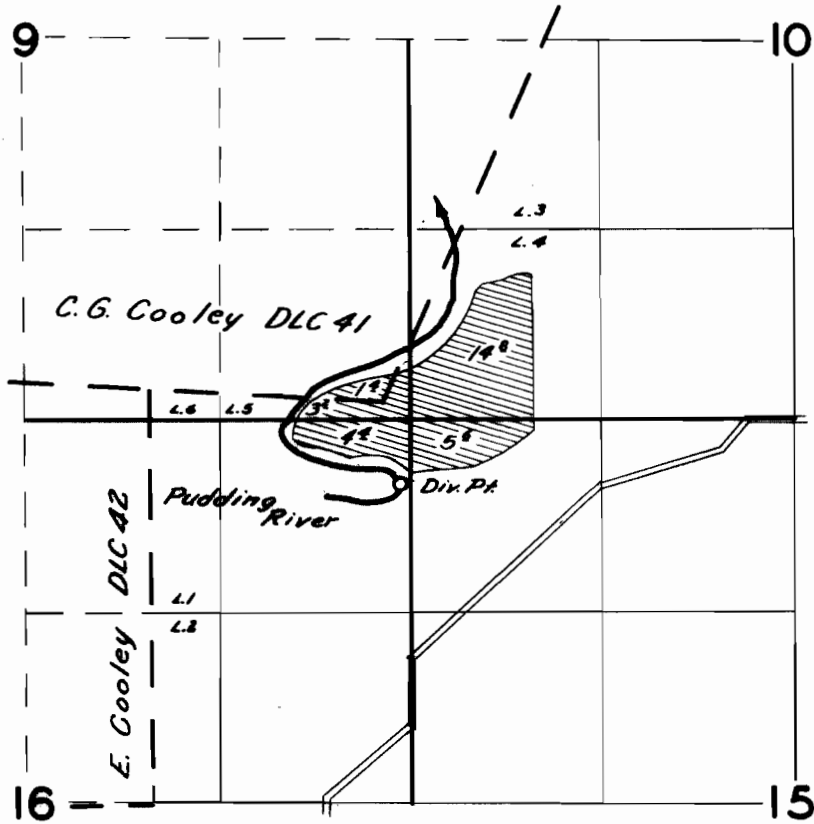

FINAL PROOF SURVEY
UNDER

Application No. 29601... Permit No. 23308..
IN NAME OF

.....*Ivan Brundidge*.....

Surveyed *May 28* 1956, by *C.O. Bartels*.....