


T. 4 N. R. 1 W. W. M.

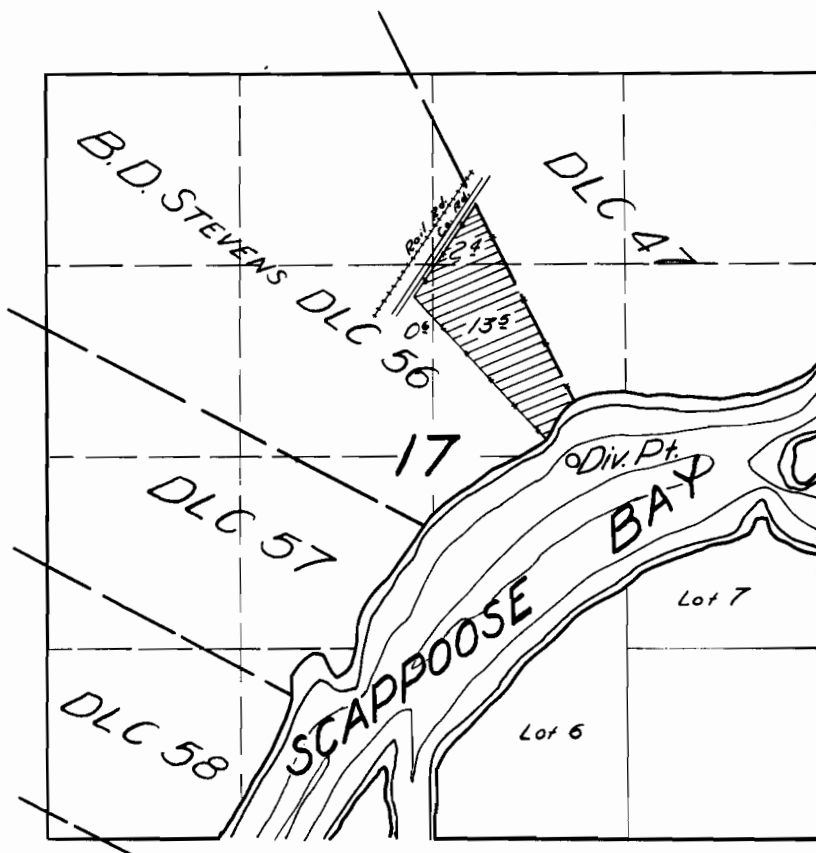

FINAL PROOF SURVEY
UNDER

Application No. 30254 Permit No. 23656
IN NAME OF

VON N. & IDA L. SMITH

Surveyed 9 July 1956, by [Signature]