


T. 13 S. R. 29 E. W. W.

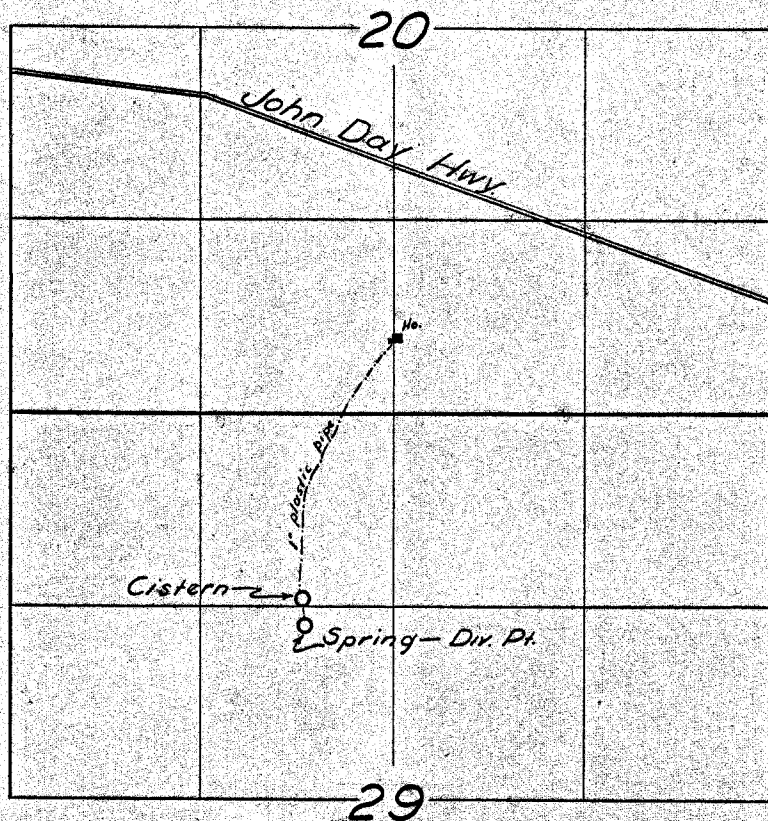

FINAL PROOF SURVEY
UNDER

Application No. 30260 Permit No. 23721

IN NAME OF

ROBERT L. CARTER

Surveyed 27 Oct. 1956, by [Signature]