


T. 6 S. R. 3 W. W. M.

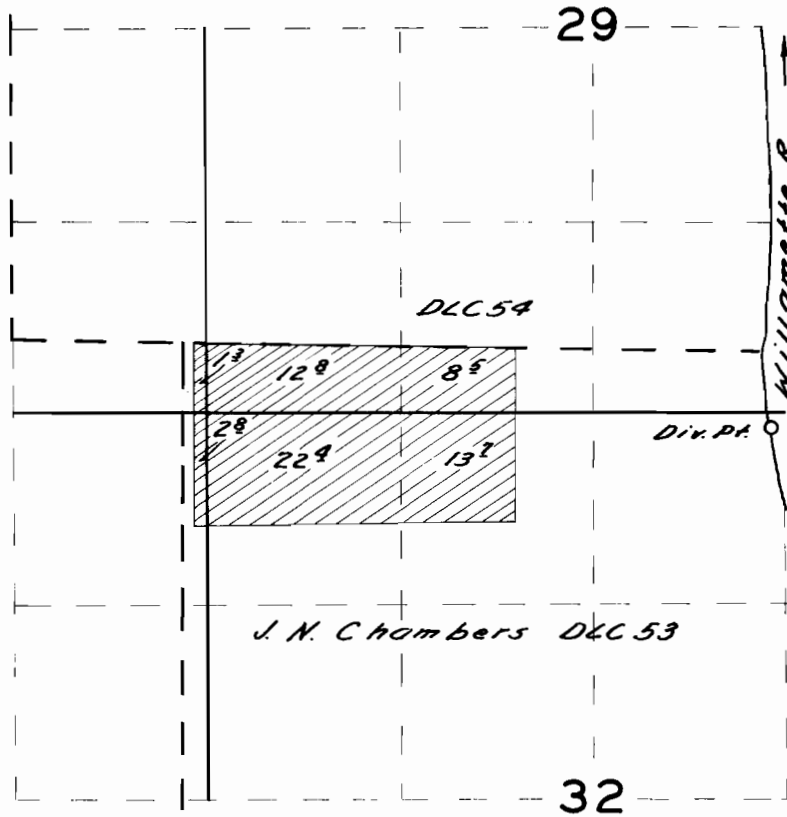

**FINAL PROOF SURVEY**

UNDER

Application No. 30250 Permit No. 29226

IN NAME OF

M. E. Schlabach

Surveyed Sept. 28 19.56 by C. O. Bartels