


T. 4 N. R. 24 & 25 E. W. W.

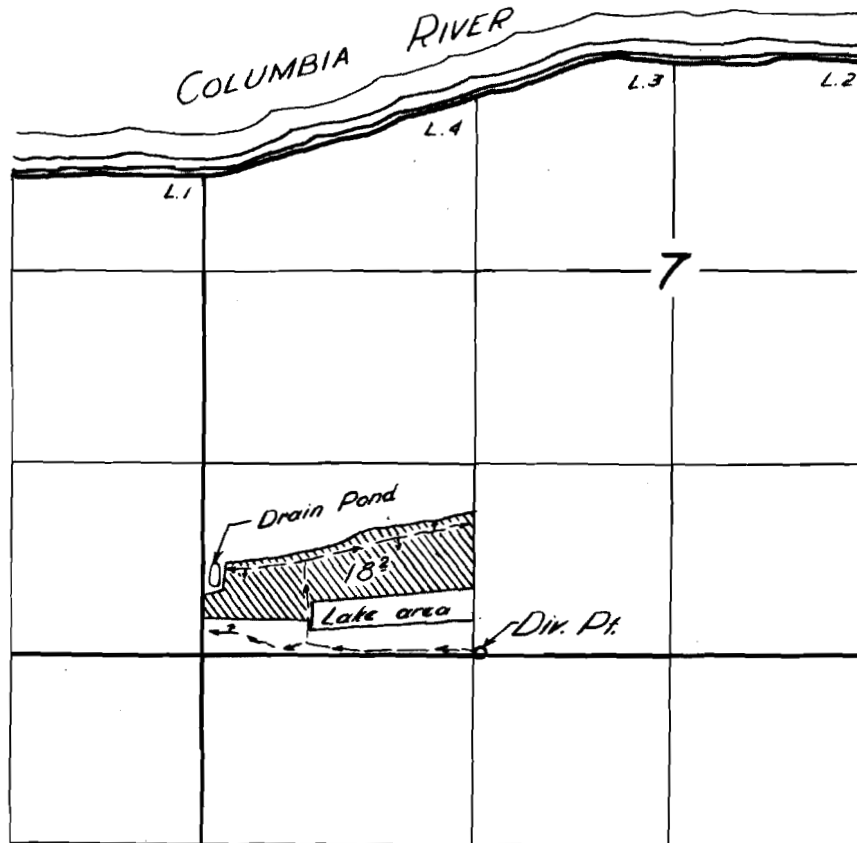

FINAL PROOF SURVEY
UNDER

Application No. 31158 Permit No. 24555

IN NAME OF

CHARLES A. ANDEREGG

Surveyed 29 Feb. 1957, by C. L. WHEELER