


T. 3S. R. 2E. W.M.

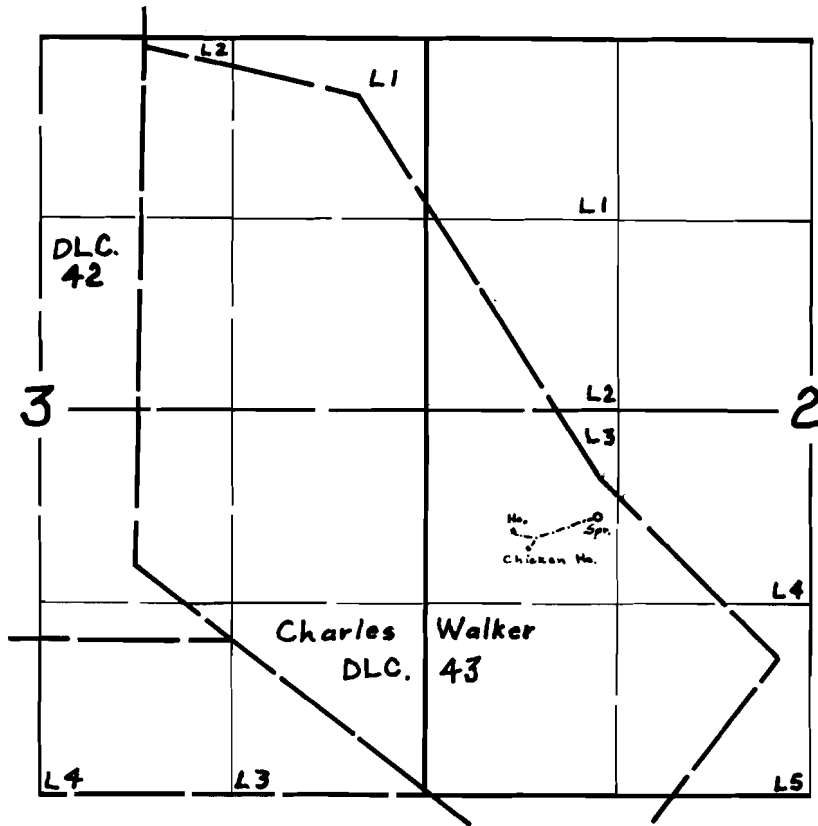

FINAL PROOF SURVEY
UNDER

Application No. 20175 Permit No. 15721...
IN NAME OF

MAYBELLE EBEN

Surveyed 20 June 1956, by M. Bish