


T. 6 S. R. 3 W. W. M.

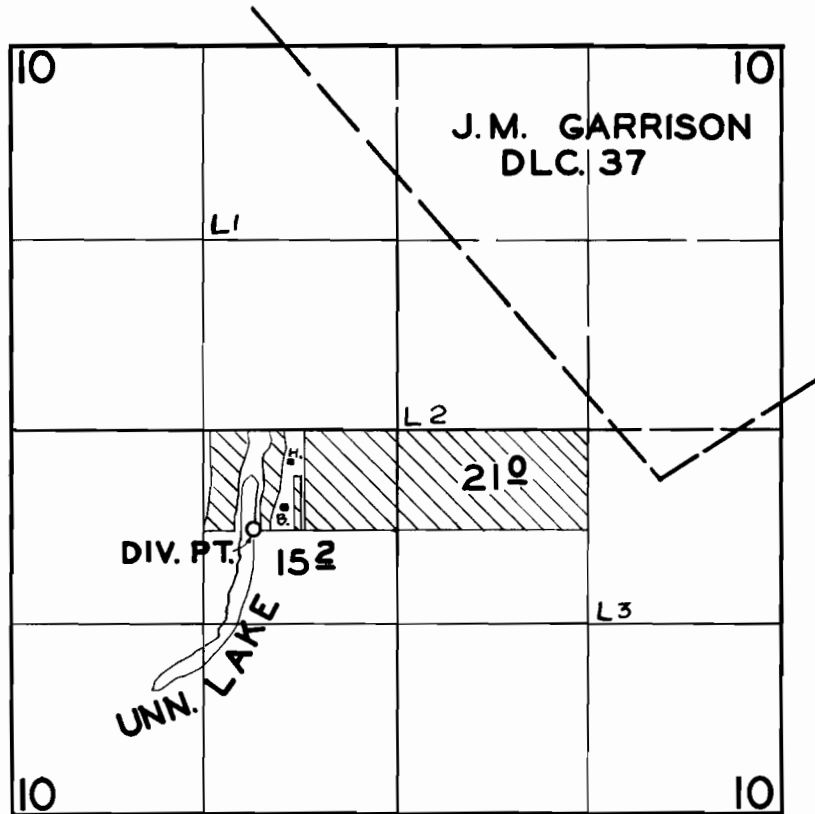

**FINAL PROOF SURVEY**  
UNDER

Application No. **20947** Permit No. **16403**  
IN NAME OF

**DON H. WALL**

Surveyed **3 JULY 1956**, by **M. BISH**