


T. 3S. R. 4E. W.M.

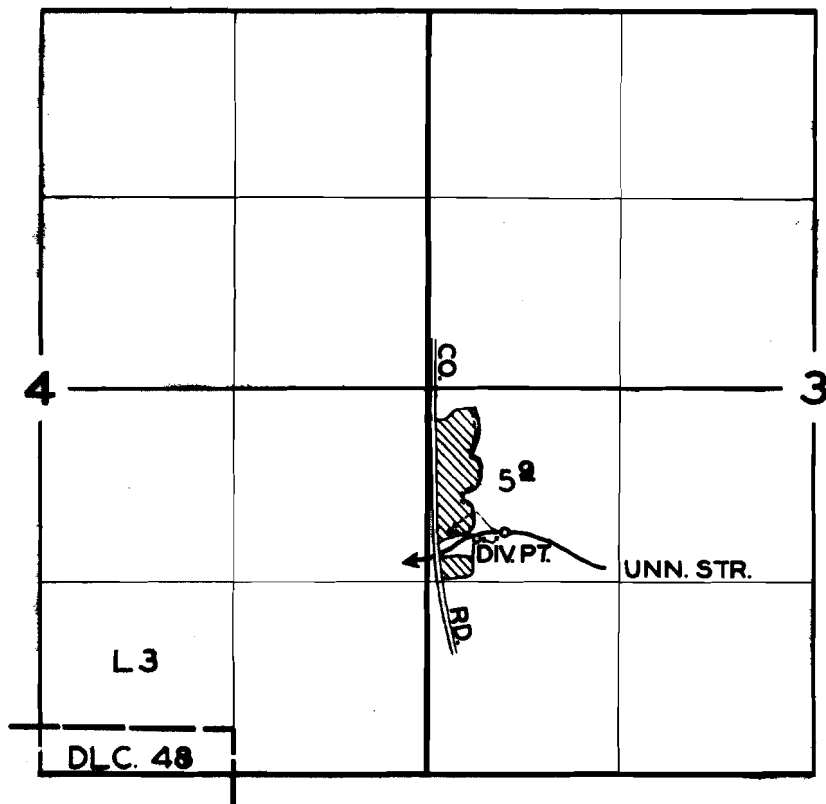

FINAL PROOF SURVEY
UNDER

Application No. 22417 Permit No. 17669
IN NAME OF

W. R. CASTILE

Surveyed 6 APR. 1956, by R.D. BEST

DFK-4D-48

hwt