


T.2S. R.1W. W.M.

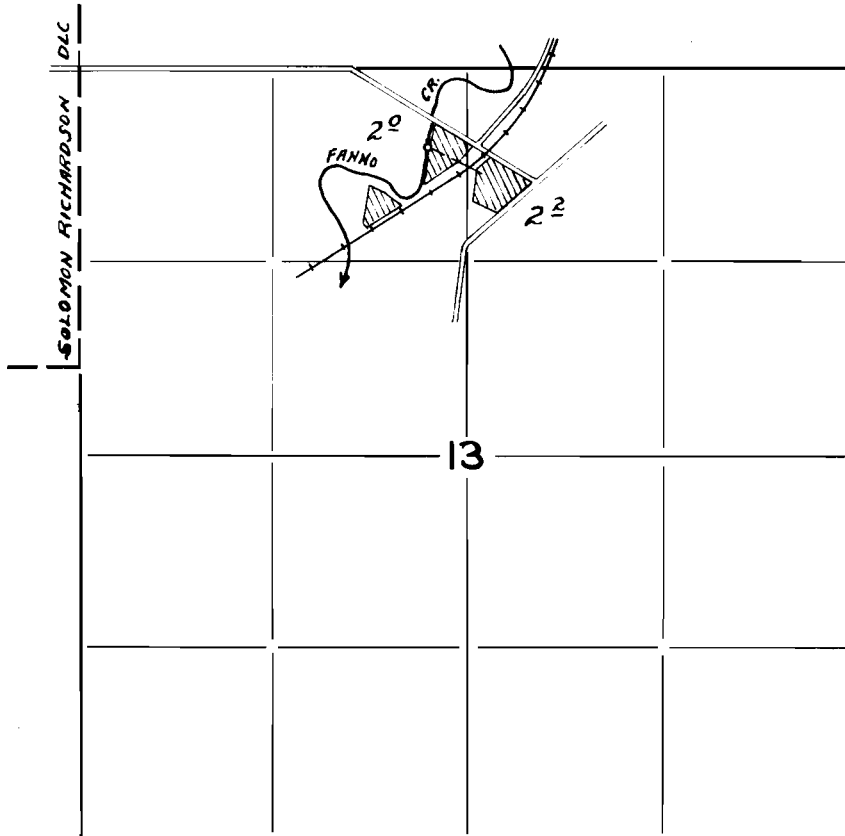

FINAL PROOF SURVEY

UNDER

Application No. 22844 Permit No. 17983

IN NAME OF

FRANK LENARD

Surveyed 5-8 1956, by R.H. WHITBY