


T. 3 S. R. 7 E. W. M.

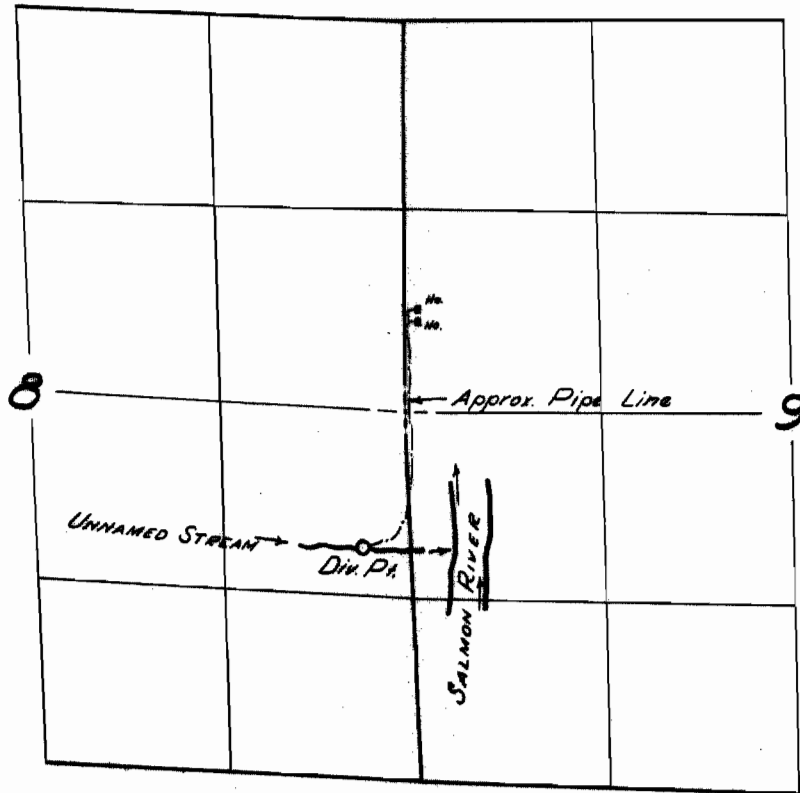

FINAL PROOF SURVEY

UNDER

Application No. 22493 Permit No. 18016

IN NAME OF

J. P. LICH

Surveyed 12 June 1956, by *[Signature]*