


T. 3S. R. 2E. W.M.

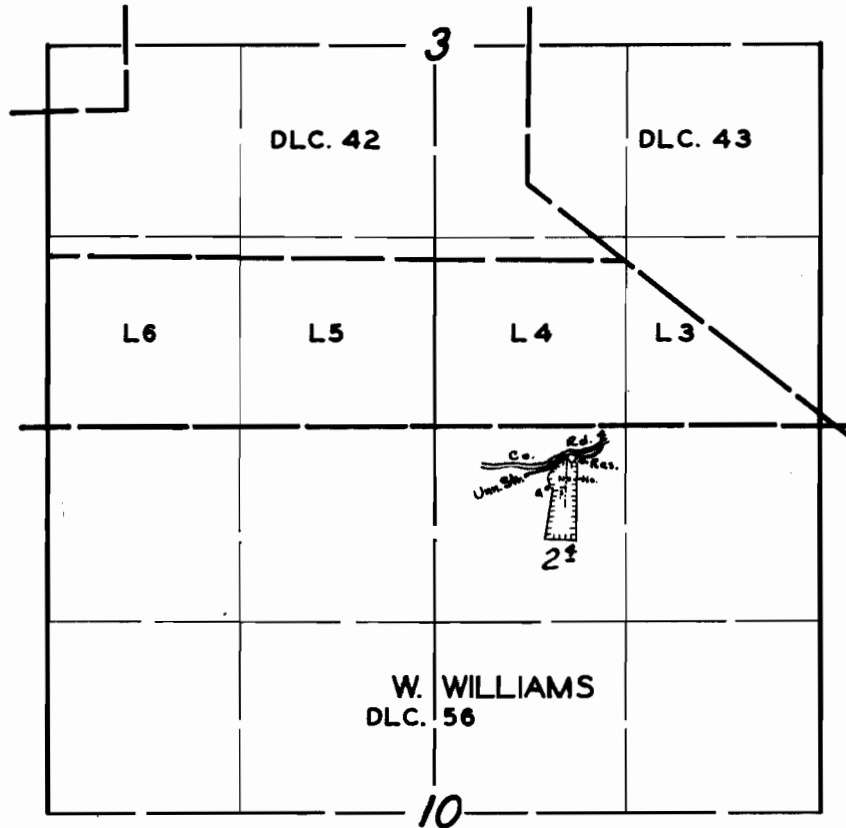

FINAL PROOF SURVEY

UNDER

R-23800

R-978

Application No. 23700 Permit No. 18807

IN NAME OF

FLOYD J. & IDA M. PECK

Surveyed 20 June 1956, by M. Bish