


# T. 7 S. R. 1 E. W. M.

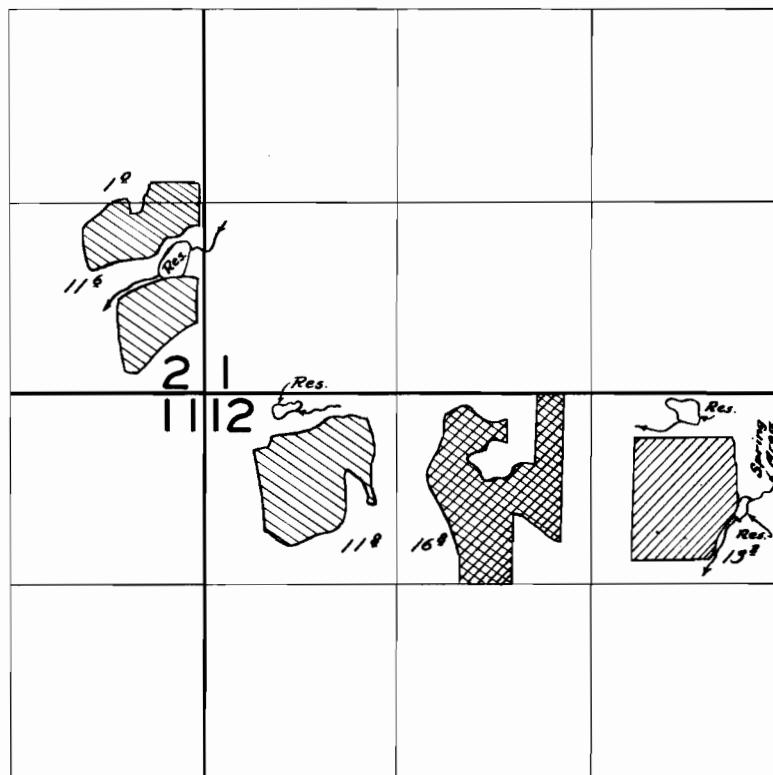

R-24375

R-25562

R-25562; Irrigated from Res. Under R-24375

## FINAL PROOF SURVEY

Application No. *R-24375* Permit No. *R-1016*  
*24376* *19232*  
*R-25562* *R-1203*  
*25563* *20513*

IN NAME OF

*Clyde McKillop*  
*Roy McKillop*

Surveyed *May 29 1956*, by *R.H. Whitby*