

N-S 40 LINES


DRAFTED

INCORRECTLY

SEE MAP APP #

R-33454

T.3S., R.1W., W.M.

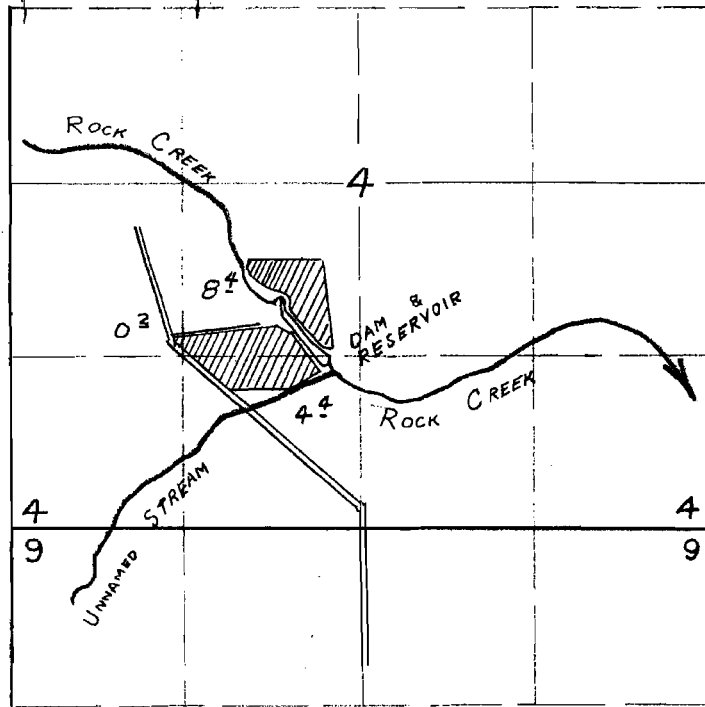

FINAL PROOF SURVEY

UNDER

R-24514

R-1038


Application No. 24515 Permit No. 19461

IN NAME OF

ELGIN F. SCHAMBURG

Surveyed 5-4 1956 by R. D. BEST

# T3S. RIW. WM.

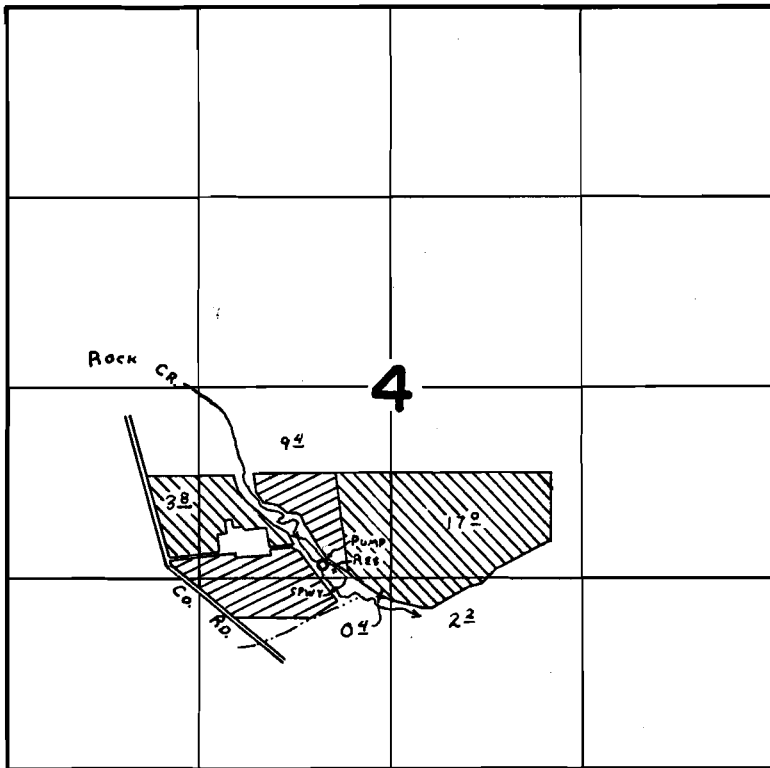

DAM Loc: 1260' N. { 330' W. } BOTH FROM S. 1/4 COR. SEC. 4.  
 PUMP Loc: 1410' N. { 470' W. }  
 ▨ - CERT. # 22991  
 ▩ - APP. # 53455

## FINAL PROOF SURVEY UNDER

Application No. R-53454 53455 Permit No. R-6384 39869  
 IN NAME OF

JACQUE E. PARSONS

Surveyed AUG. 18 1978, by C. L. HUGHES