

N-S 40 LINES


DRAFTED

INCORRECTLY

SEE MAP APP #

R-23954

T.3 S., R.1 W., W.M.

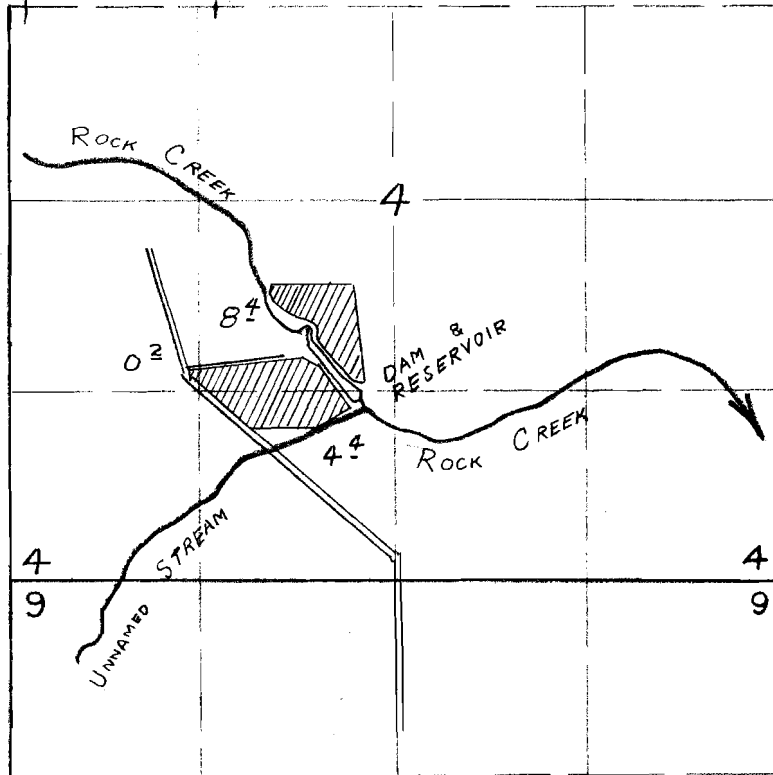

FINAL PROOF SURVEY

UNDER

R-24514

R-1038

Application No. 24515 Permit No. 19461

IN NAME OF

ELGIN F. SCHAMBURG

Surveyed 5-4 1956 by R. D. BEST