

	15			14			13		
	22			23			24		
	27			26			25		
	34			35			36		


FROM OFFICE OF THE STATE ENGINEER, SALEM, OREGON


Willow Creek Adjudication

3 S. 26 E.

[illegible]

Range 26 E.W.M.

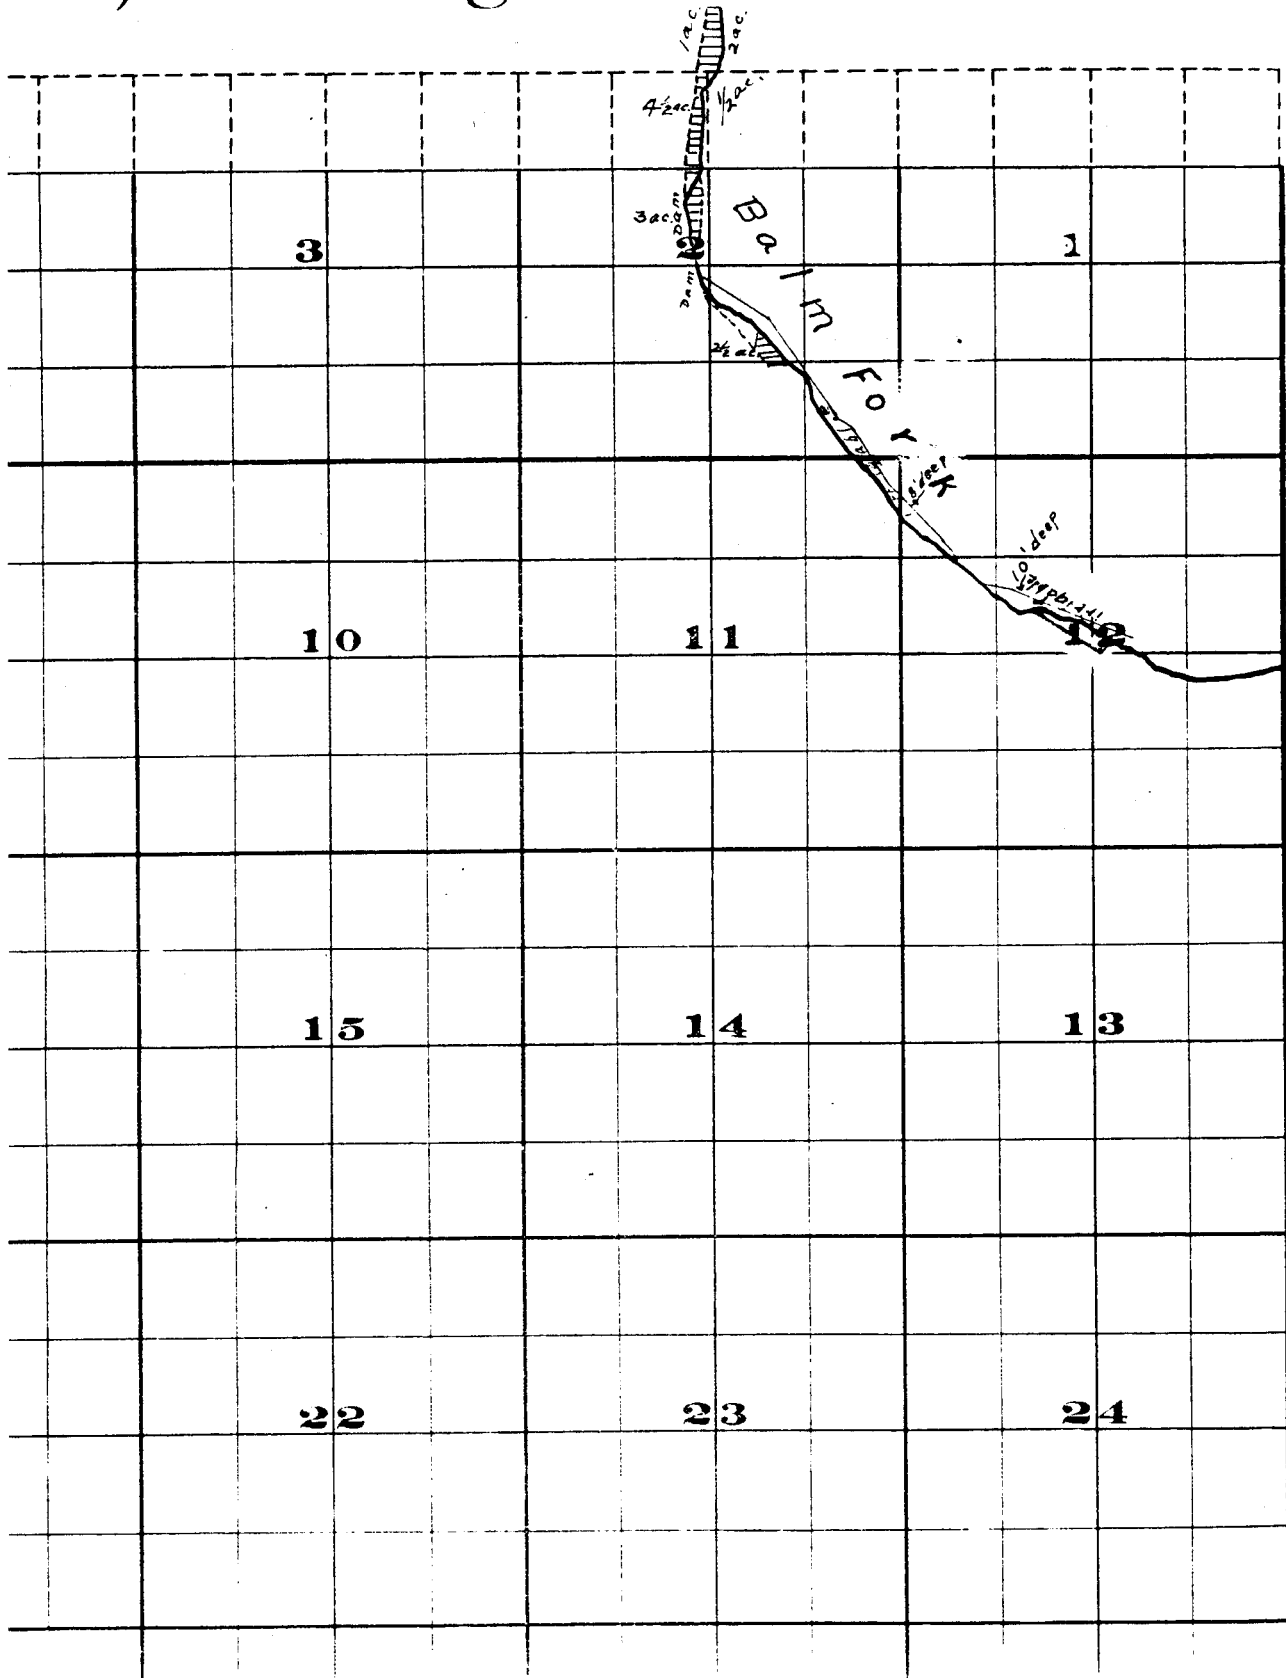


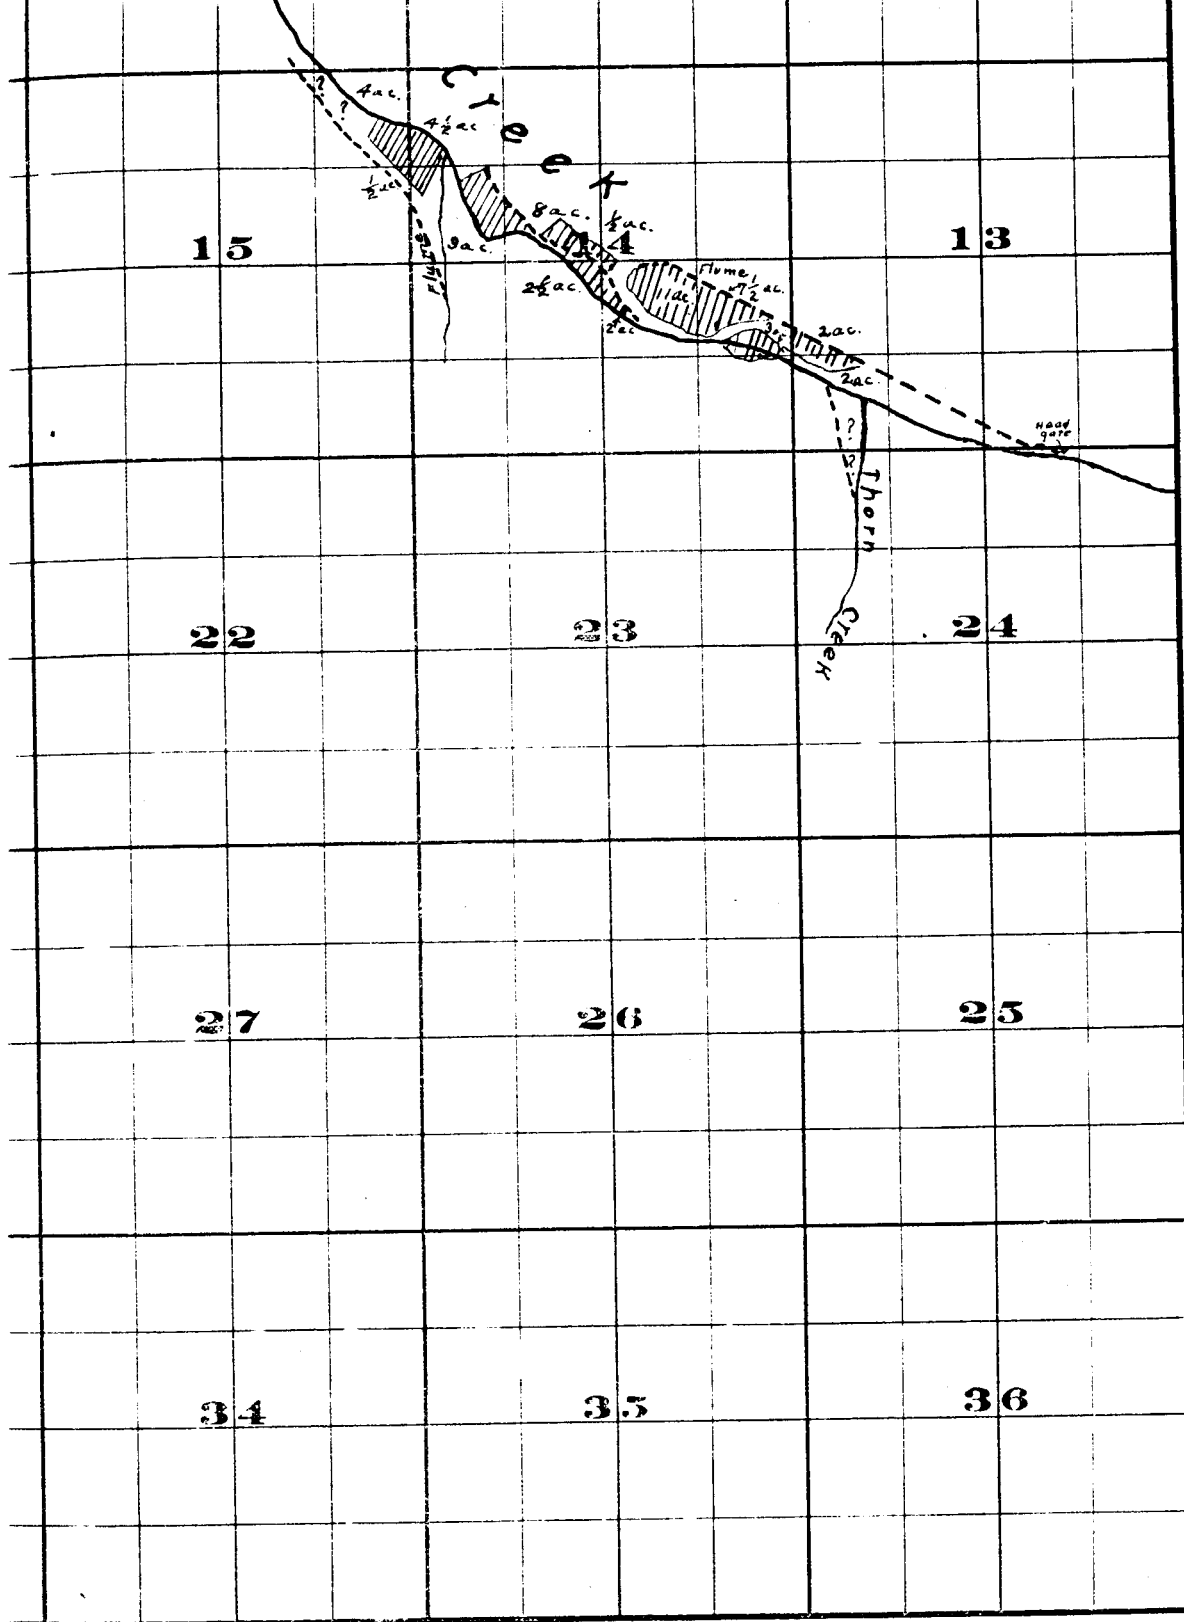

FROM OFFICE OF THE STATE ENGINEER, SALEM, OREGON

Willow Creek Adjudication

4 S. 26

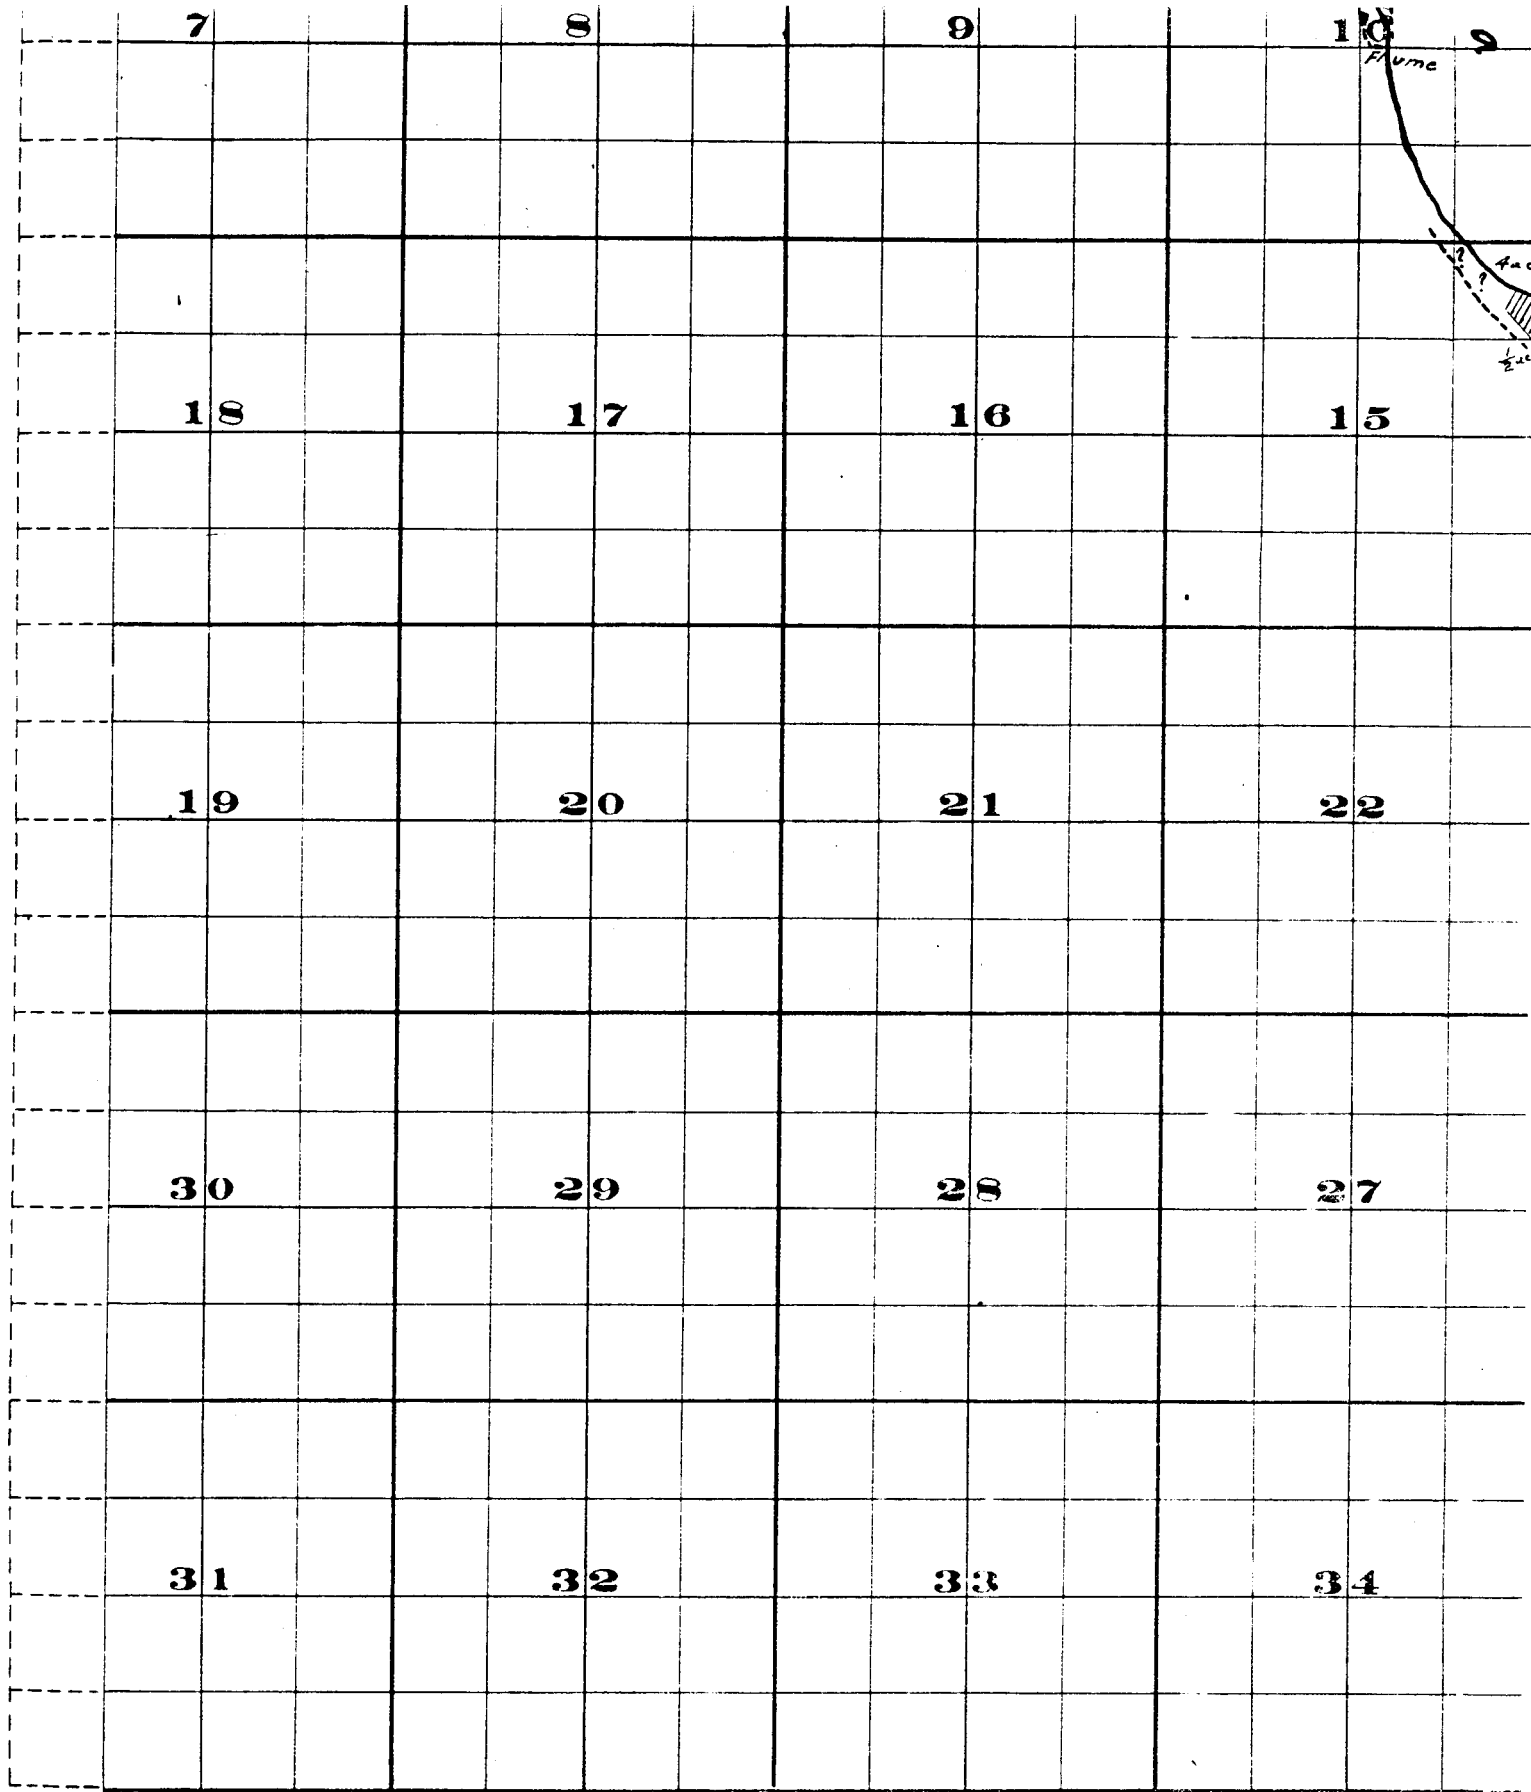

THE B. B. B. CO. PRINTERS & PUBLISHERS, CHICAGO, ILL.


Surveyed by H. K. Donnelly July 1909

John H. Lewis - State Engineer

Examined July 14, 1909.

Township 4 S.

,

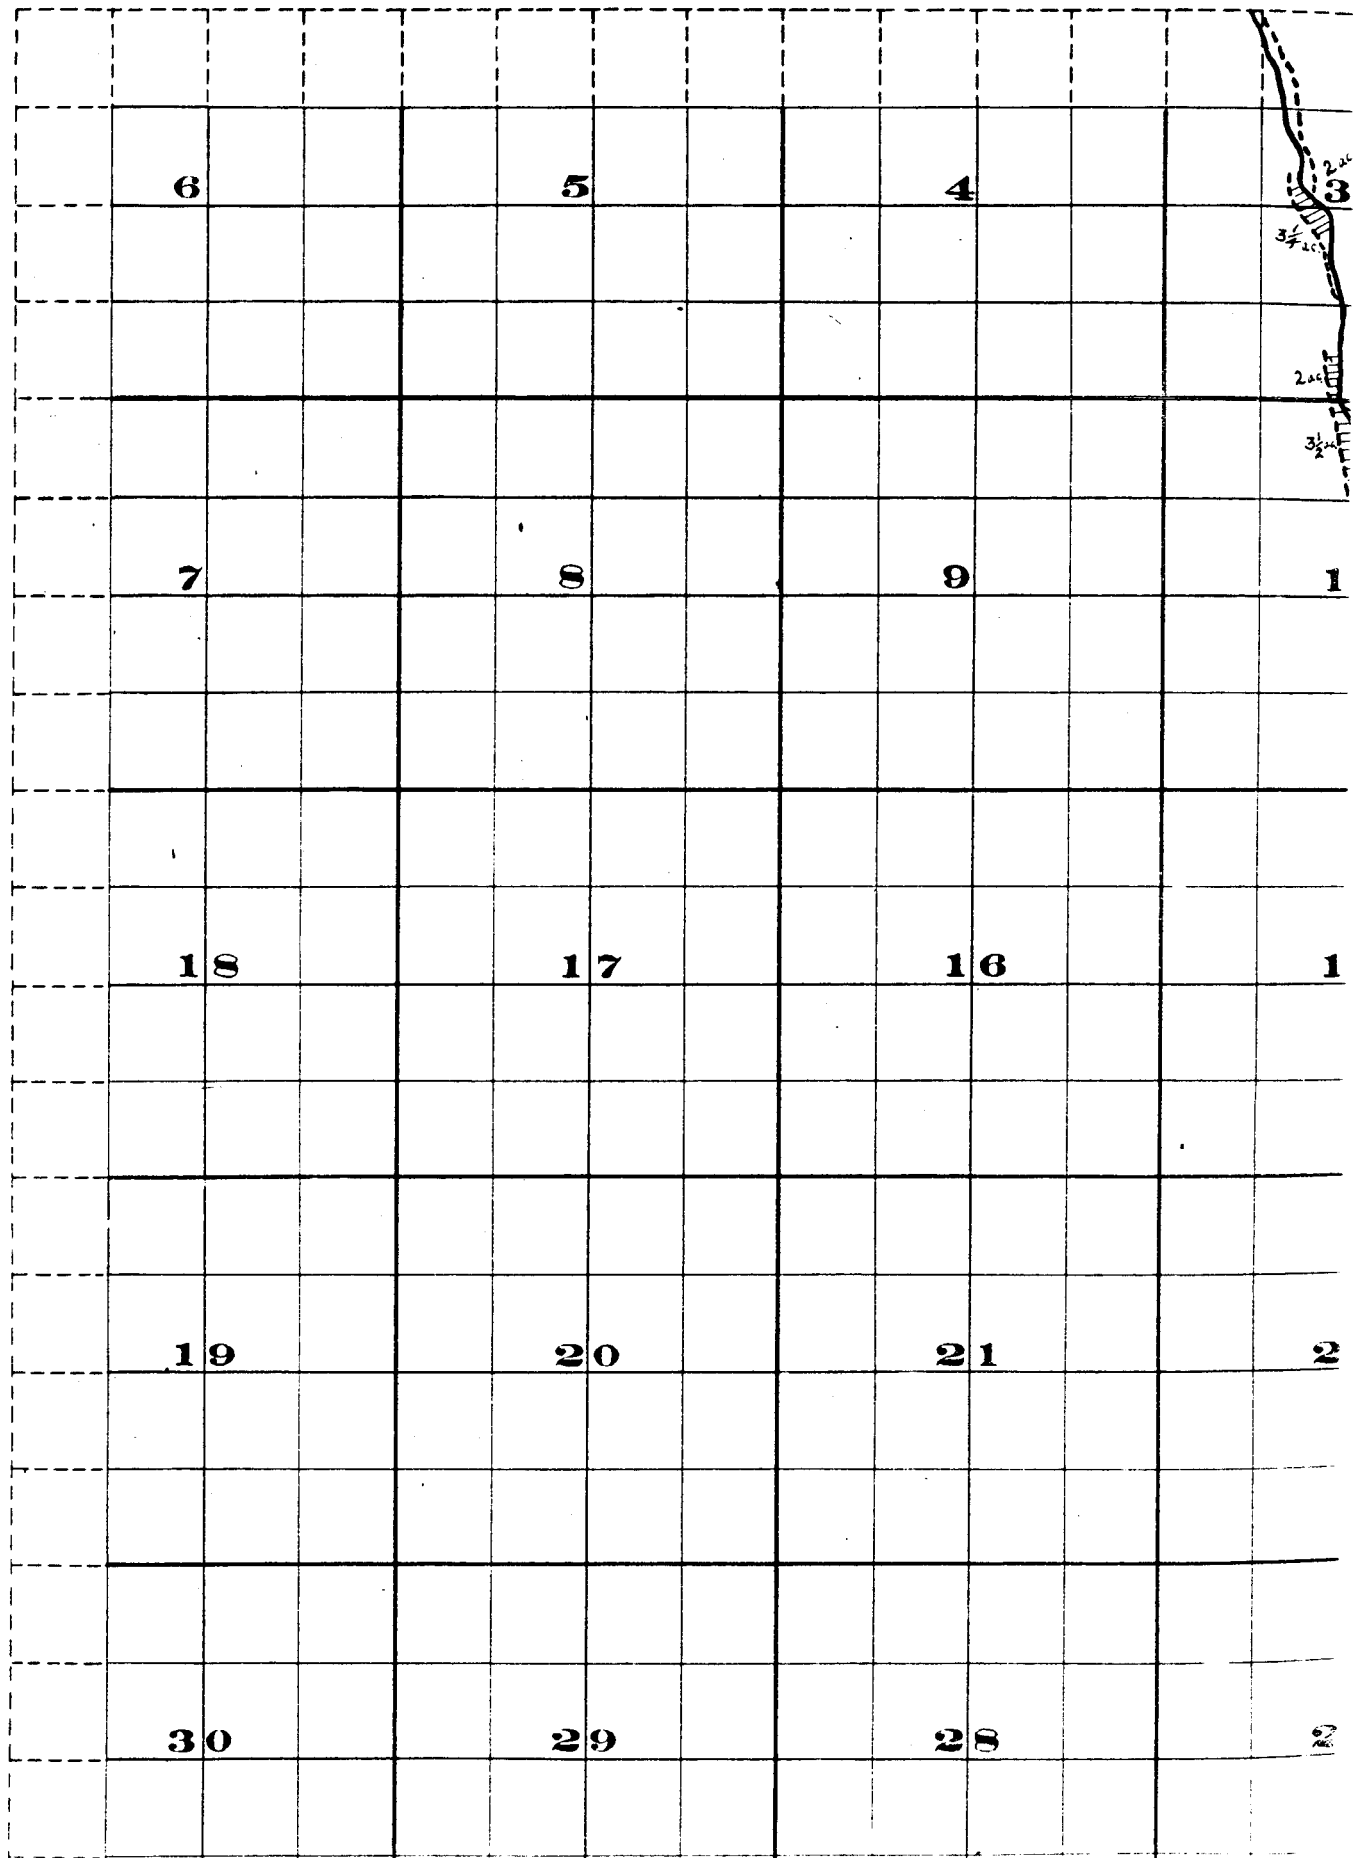

,

1

