


Copy from
file S-26657

T. 4 S. R. 2 E. W. M.

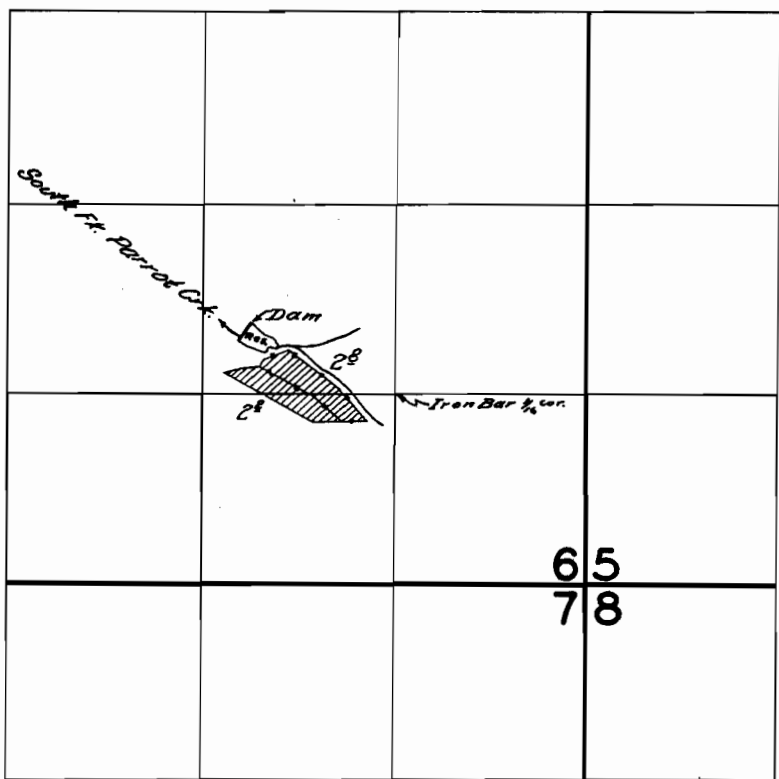

FINAL PROOF SURVEY

UNDER

Application No. *R-26656* Permit No. *R-1283*
26657 *20878*
IN NAME OF

Otis Hunt

Surveyed *April 1*, 1957, by *G.O. Bartels*