


T.5 S. R. 4 W.W.M.

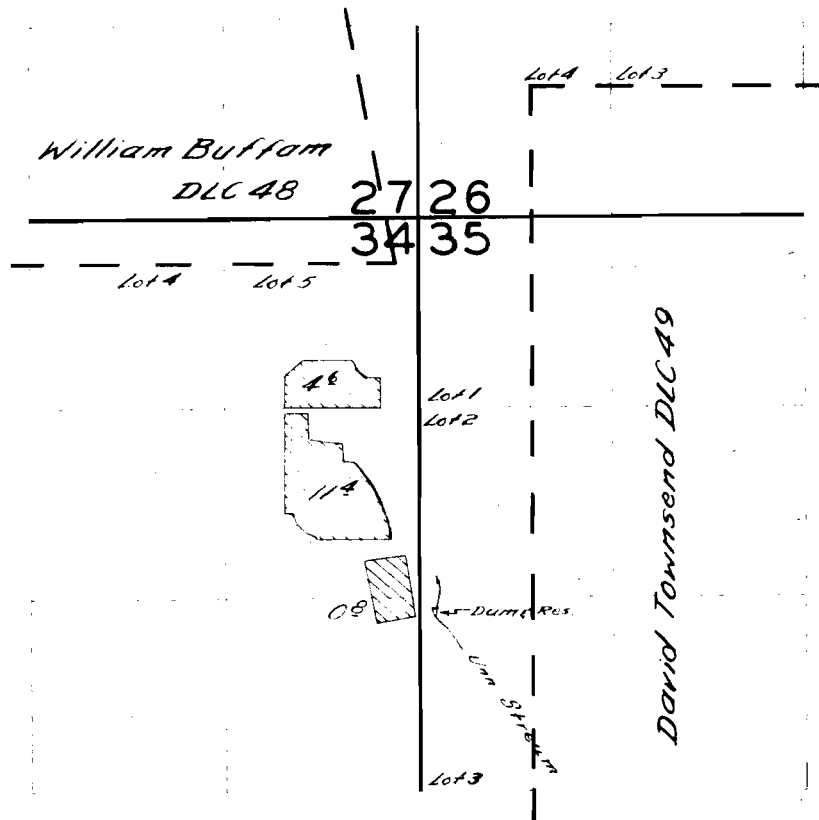

R-26104
 26105
 24556
 R-1409
 21661
 19362

ED O'REILLY

Surveyed May 19 1855 by T. Jones
 Mar 27 56 C.O. Bartels