


T. 29 S., R. 14 W. W.M.

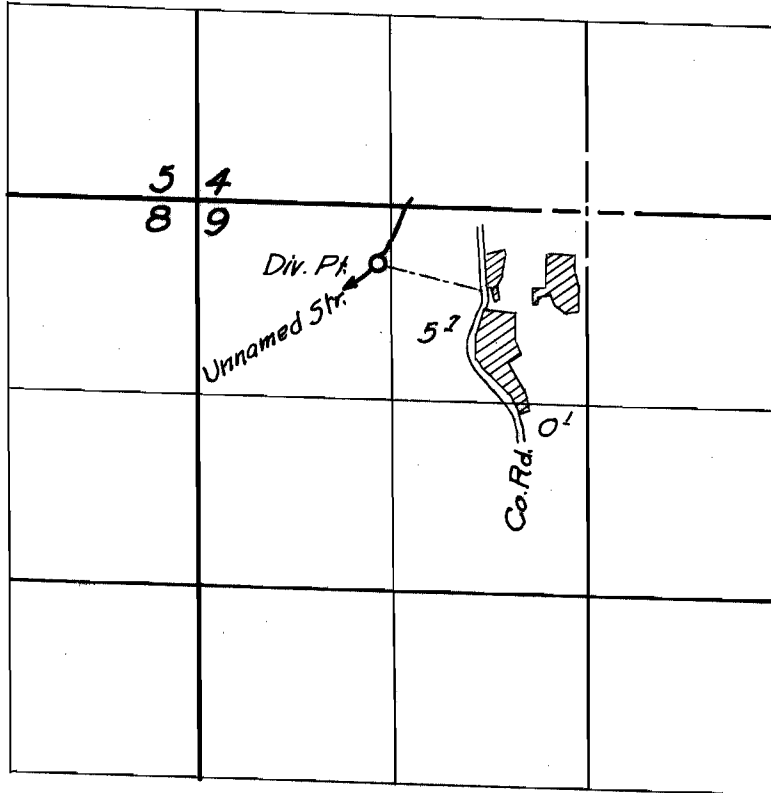

**FINAL PROOF SURVEY**

UNDER

Application No. 23022... Permit No. 18143.....

IN NAME OF

RODERICK J. NIELSON

Surveyed 15 March 1955, by H.L. Coffman.....