


T. 2 S., R. 2 W., W. M.

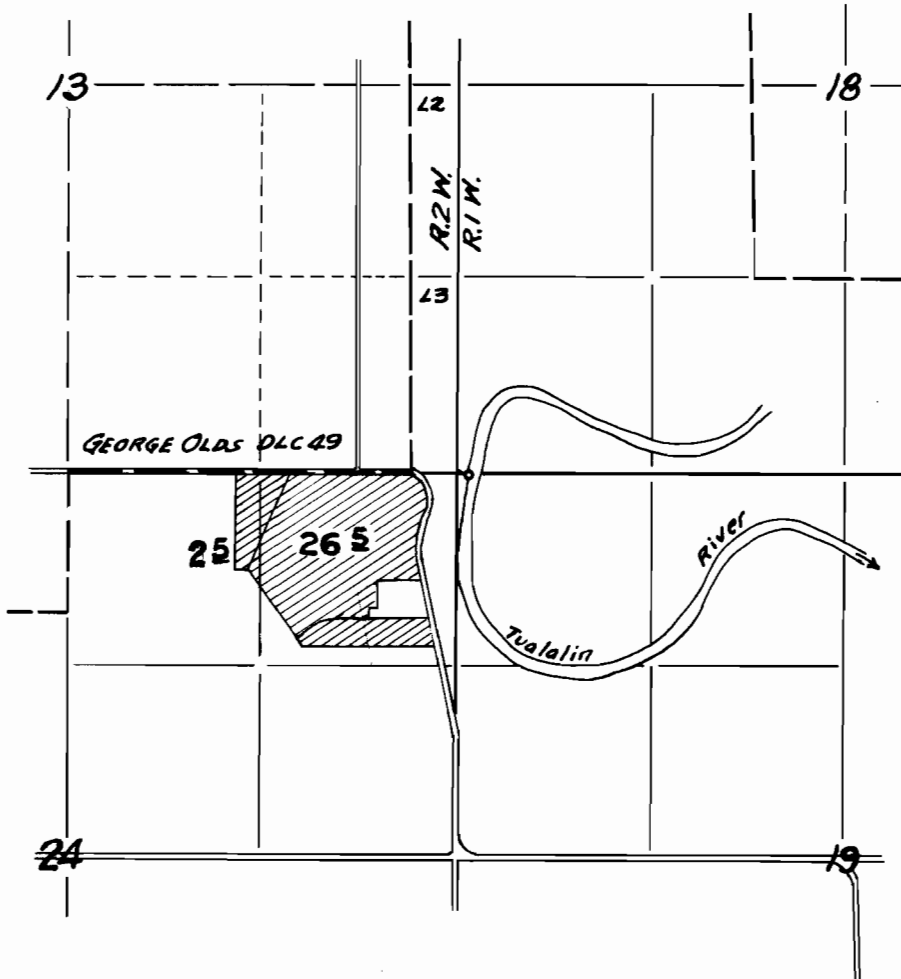

FINAL PROOF SURVEY

UNDER

Application No. 23584 Permit No. 18606

IN NAME OF

EDWARD L. RUPPRECHT

Surveyed 4-27 1956, by M. BISH