


T. 3N R. 2W W.M.

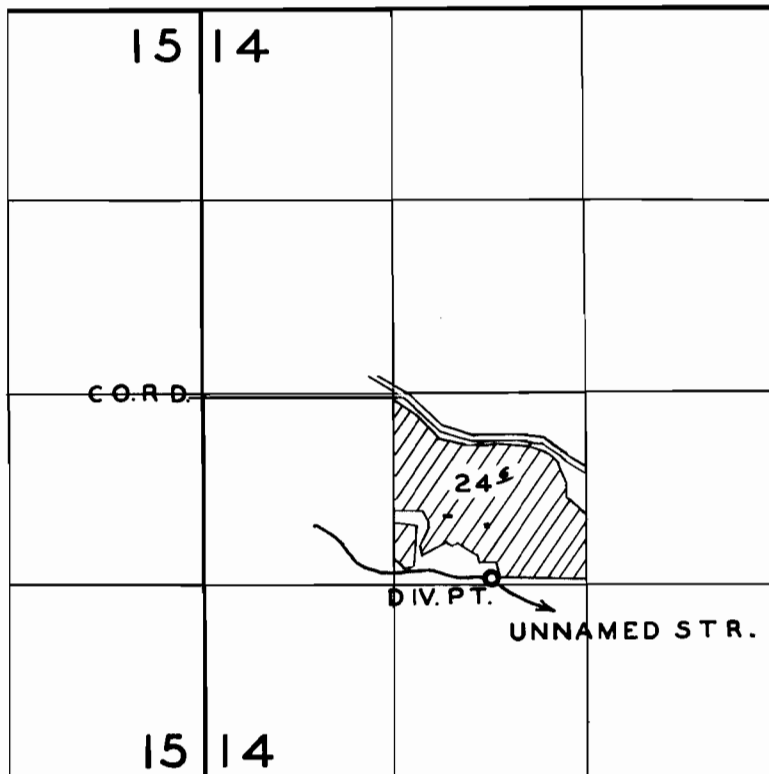

**FINAL PROOF SURVEY**  
UNDER

Application No. 2.4.18.6. Permit No. 190.18...  
IN NAME OF

**GILBERT L. AND BERNICE ANNIA**

Surveyed AUG. 1, 1956, by R. H. WHITBY

1956 V  
P.W.G.