


T. 4 N. R. 2 W. W. M.

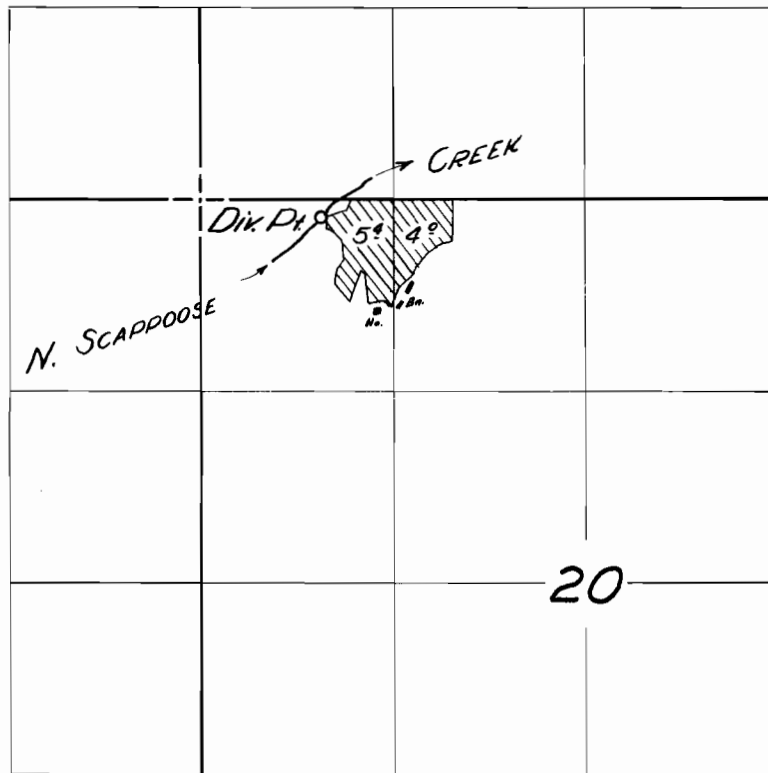

FINAL PROOF SURVEY

UNDER

Application No. 24188 Permit No. 19019

IN NAME OF

OSCAR W. HALE

Surveyed 16 July 1956, by *[Signature]*