


T. 2 S. R. 3 E. W. M.

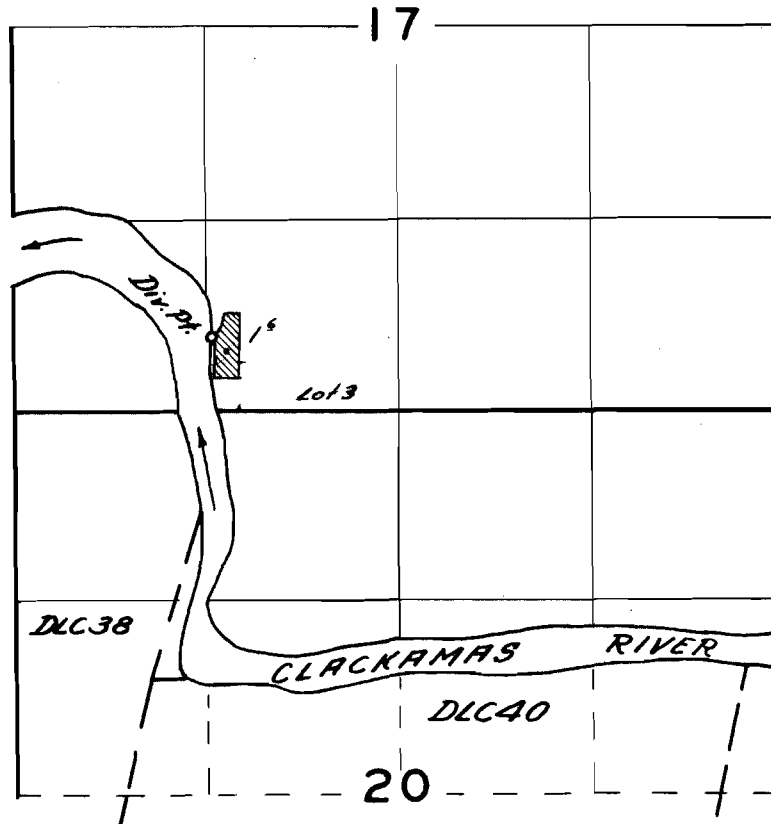

FINAL PROOF SURVEY
UNDER

Application No. 24123 Permit No. 19023
IN NAME OF

Roy & May Milligan

Surveyed June 29 1956, by R.H. Wilby

DFK-10-135