


T. 4 N. R. 2 W. W. M.

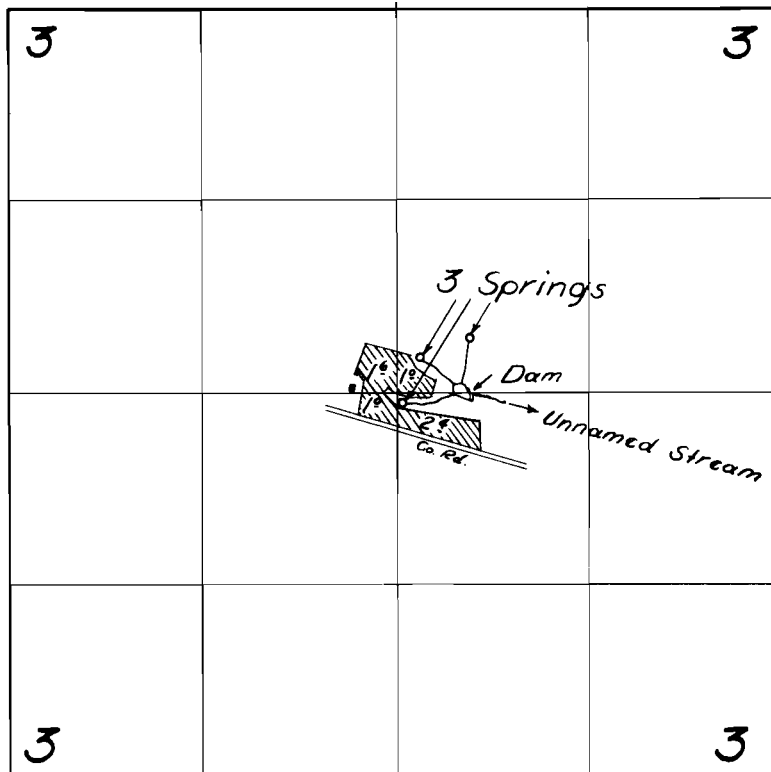

FINAL PROOF SURVEY

UNDER

Application No. 24134 Permit No. 19110

IN NAME OF

RUDOLPH WALTERS, Jr.

Surveyed 14 July 1956, by C. H. H. H. H.