
## T.305. R. 4 W.W.M.

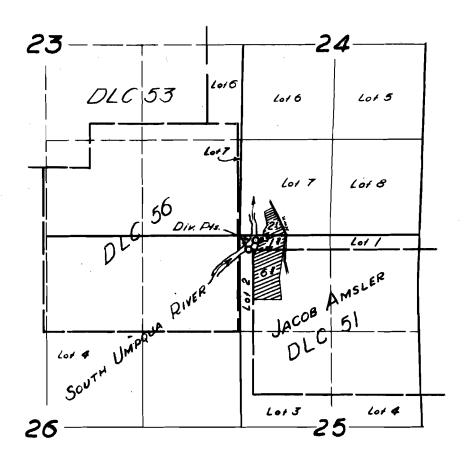

## FINAL PROOF SURVEY

**UNDER** 

Application No. 24300 Permit No. 19123 IN NAME OF

GERTRUDE WRIGHT

Surveyed 18 Oct. 1956 by Columbia