


T 5 S. R. 1 W. W.M.

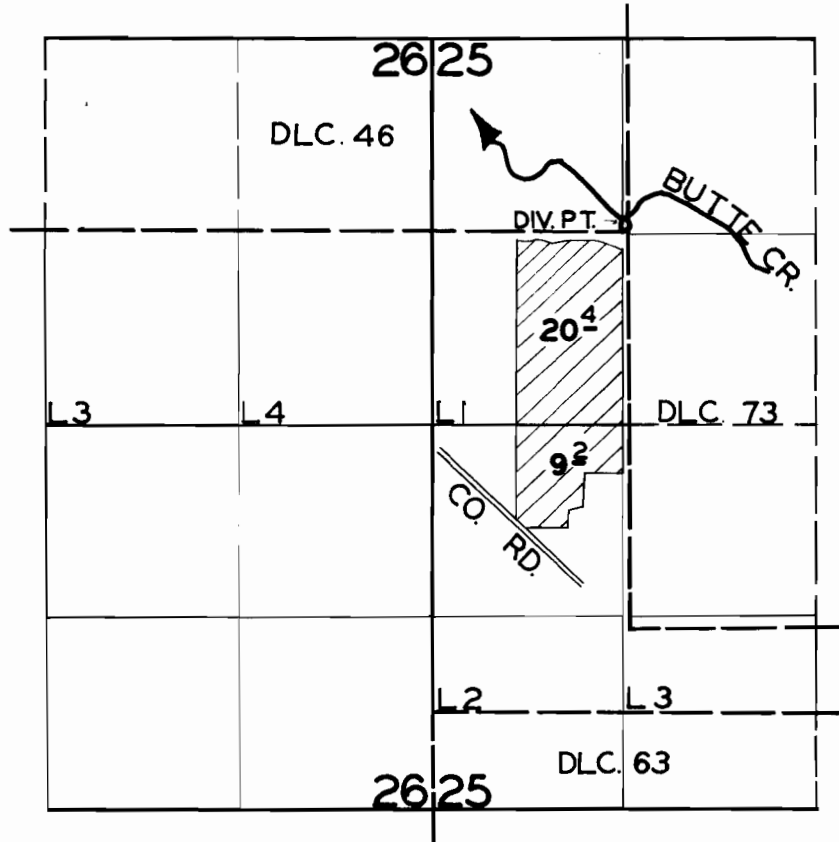

**FINAL PROOF SURVEY**

UNDER

Application No. ~~24383~~ Permit No. **19236**...

IN NAME OF

**HARALD & HAZEL GREGERSON**

Surveyed **28 FEB.** 1956, by **R.D. BEST**.....

DFK-2D-75

RWD