


T.2 N, R.3 W, W.M.

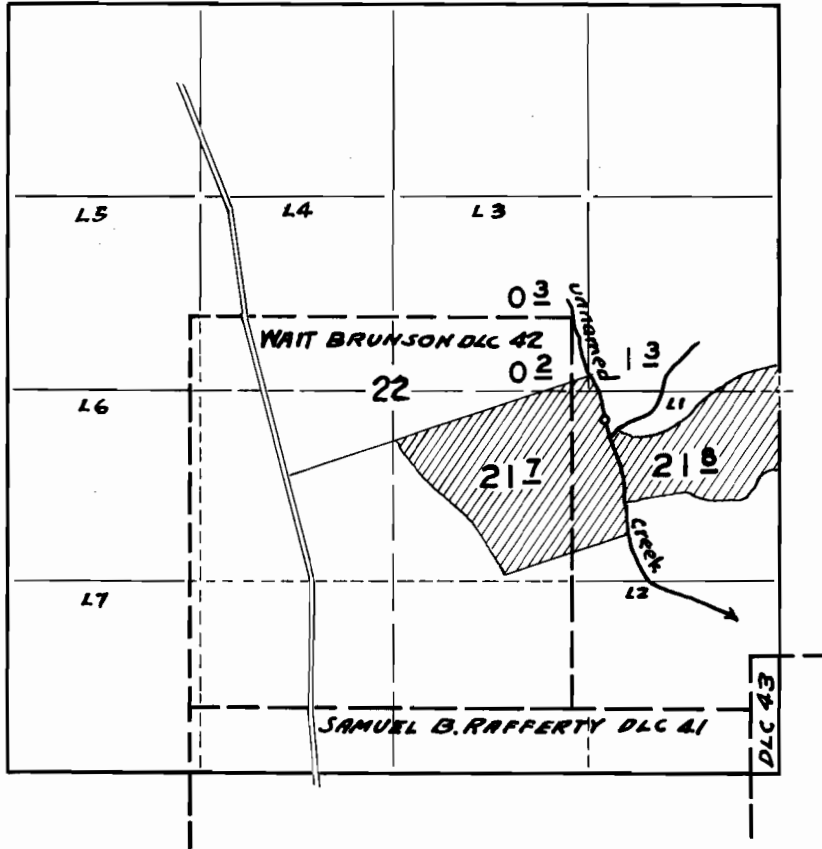

FINAL PROOF SURVEY

UNDER

Application No. 24463 Permit No. 19283.
IN NAME OF

ELMO F. GARDNER

Surveyed 4 - 11 1956, by R.H. WHITBY.