


T. S. R. / W. W. M.

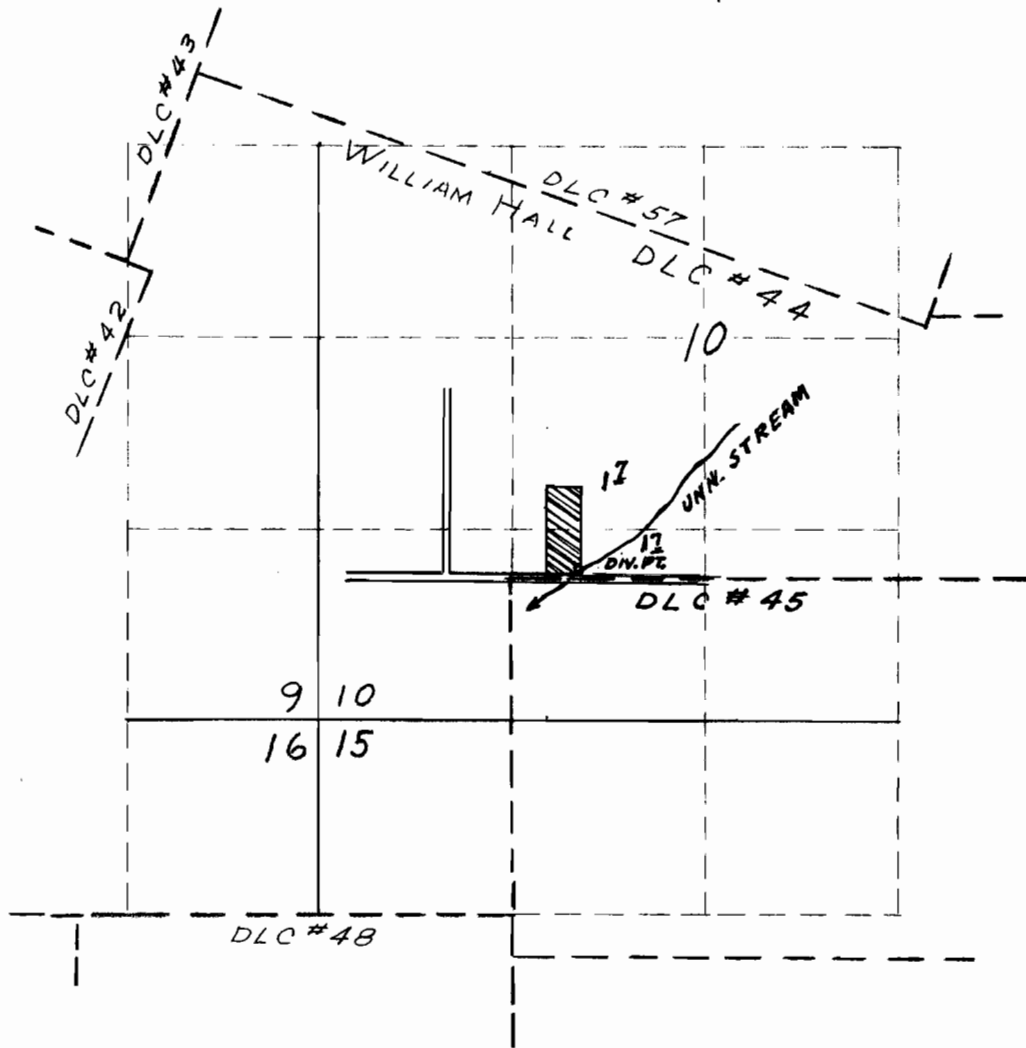

FINAL PROOF SURVEY
UNDER

Application No. 24 620 Permit No. 194 67

IN NAME OF

ROBERT R. & DOROTHY M. WIPPEL
AND HJALMAR LUNDQUIST

Surveyed 4-19-1956 by M. BISH