


T. 2 S. R. 4 E. W. M.

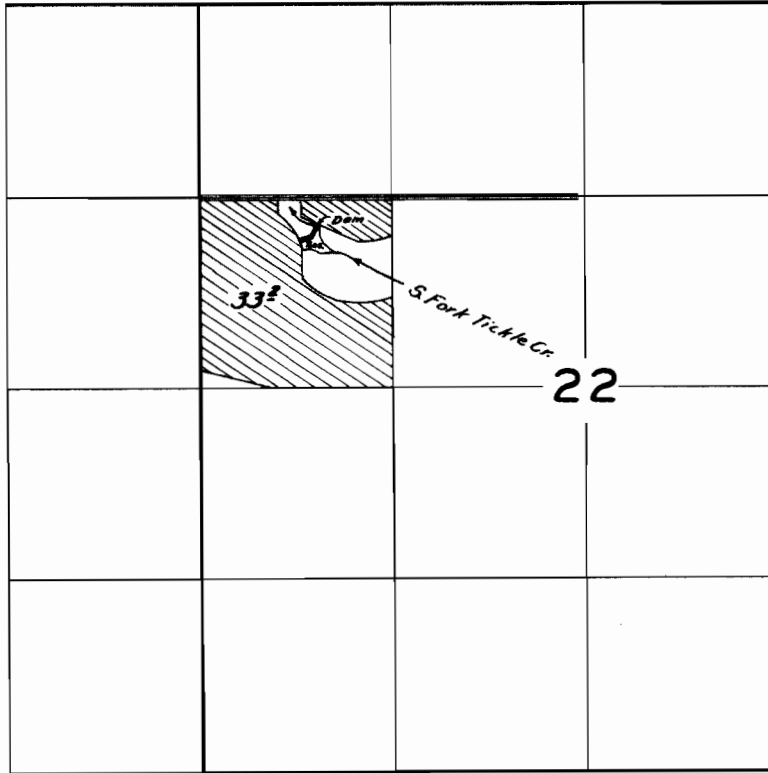

FINAL PROOF SURVEY
UNDER

Application No. 24648 Permit No. 19474
IN NAME OF

SANDY FARMS, INC.

Surveyed June 22 1956, by R.H. Whitby

DFK-40-50