


T. 3S. R. 2E. W.M.

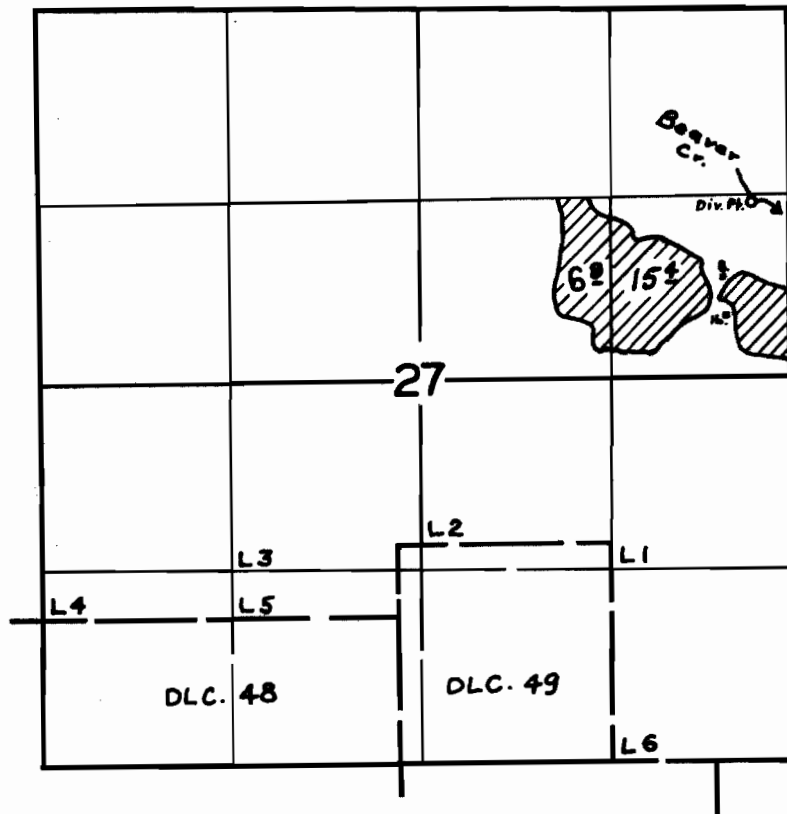

FINAL PROOF SURVEY
UNDER

Application No. 24868 Permit No. 19567
IN NAME OF

ERNEST ROEGER

Surveyed 21 June 1956, by M. Bish

DFK-30-153

RWD