


T. 4 N. R. 3 W. W.M.

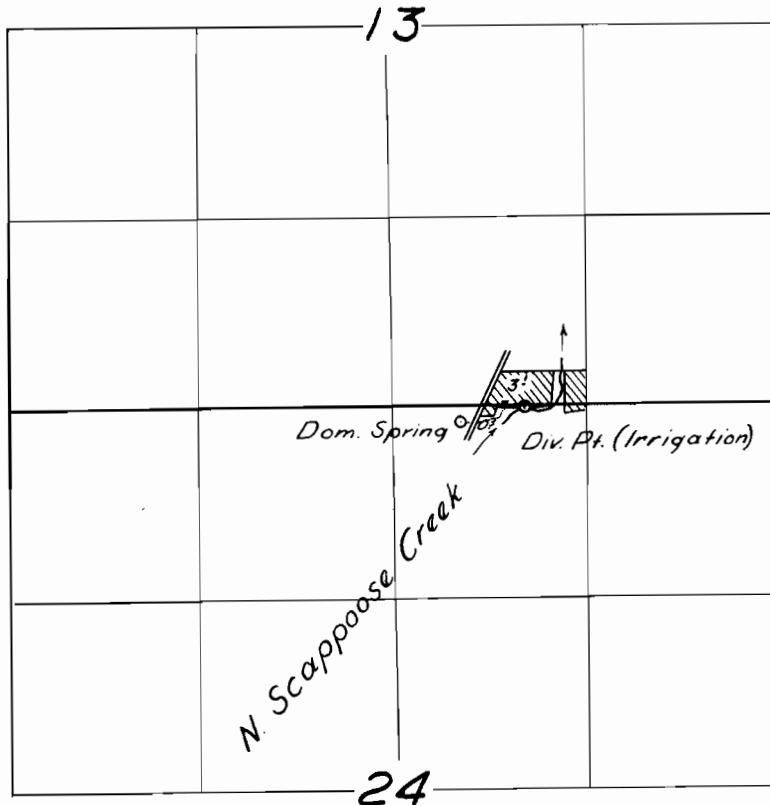

FINAL PROOF SURVEY
UNDER

Application No. 24992 Permit No. 19704
IN NAME OF

ROBERT J. BOCK

Surveyed 15 July 1956, by [Signature]