


T. 2S. R. 2E. W.M.

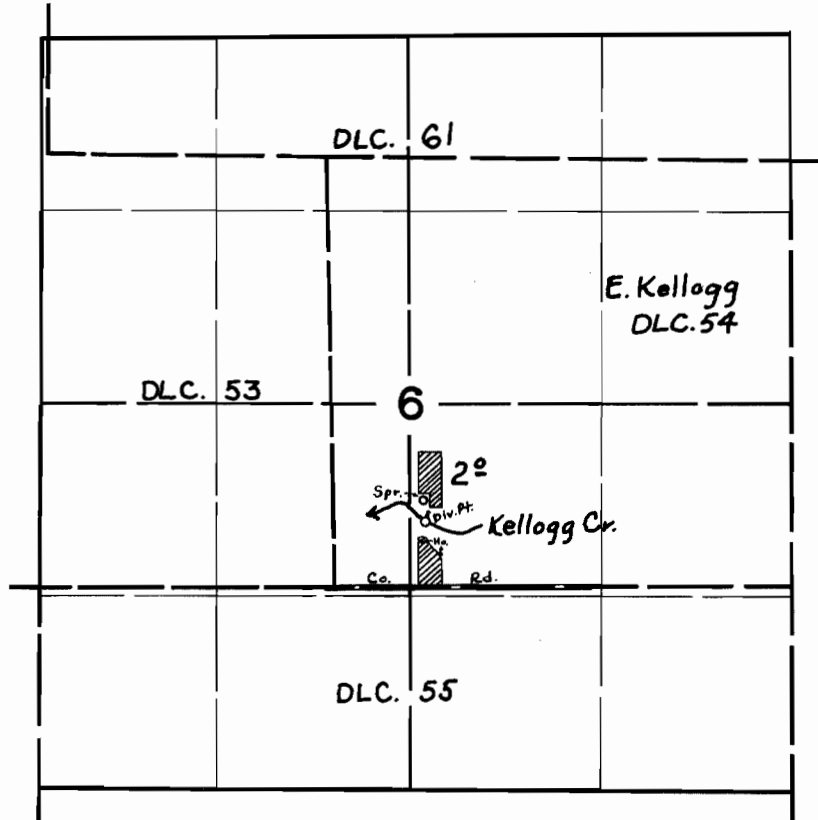

FINAL PROOF SURVEY
UNDER

Application No. 25010 Permit No. 19708
IN NAME OF

FRED L. NORTON

Surveyed 15 May 1956, by M. Bish

DFK-3D-134

2000