


T. 2 S., R. 2 W., W. M.

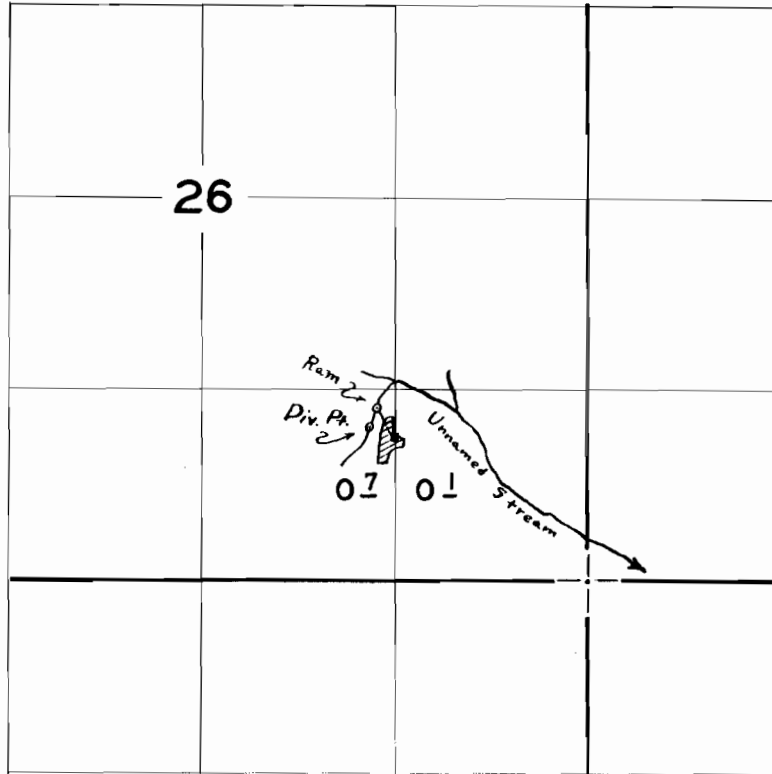

**FINAL PROOF SURVEY**

UNDER

Application No. 25040 Permit No. 19725

IN NAME OF

EARL F. BROWNE

Surveyed 4 - 30 1956 by M. B. I. S. H.