


T. 8 S. R. 2 W. W.M.

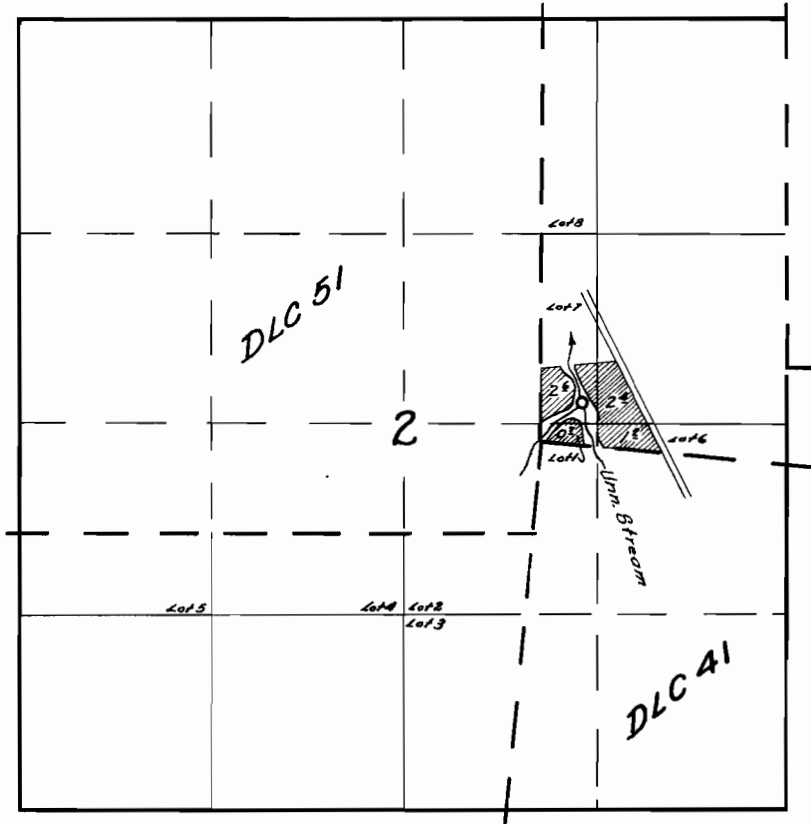

**FINAL PROOF SURVEY**

UNDER

Application No. *25870* Permit No. *20311*

IN NAME OF

*Earsel L. Stow*

Surveyed *May 21, 1956*, by *R. H. Whitby*

DFN-2D-61

C.B.