


T10 S. R. 2 W.W.M.

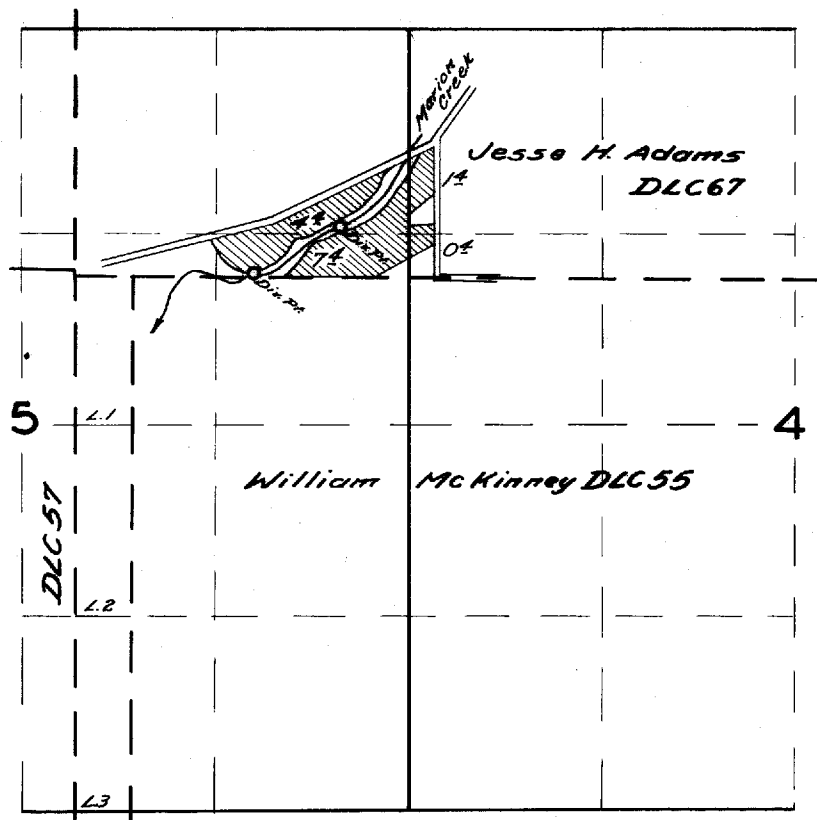

FINAL PROOF SURVEY

UNDER

Application No. 25929 Permit No. 20335
IN NAME OF

Louis E. Petersen

Surveyed May 15, 1956, by R.H. Whitby

DFN-3D-202

C.B.