


T. 6 N R. 2 W W. M.

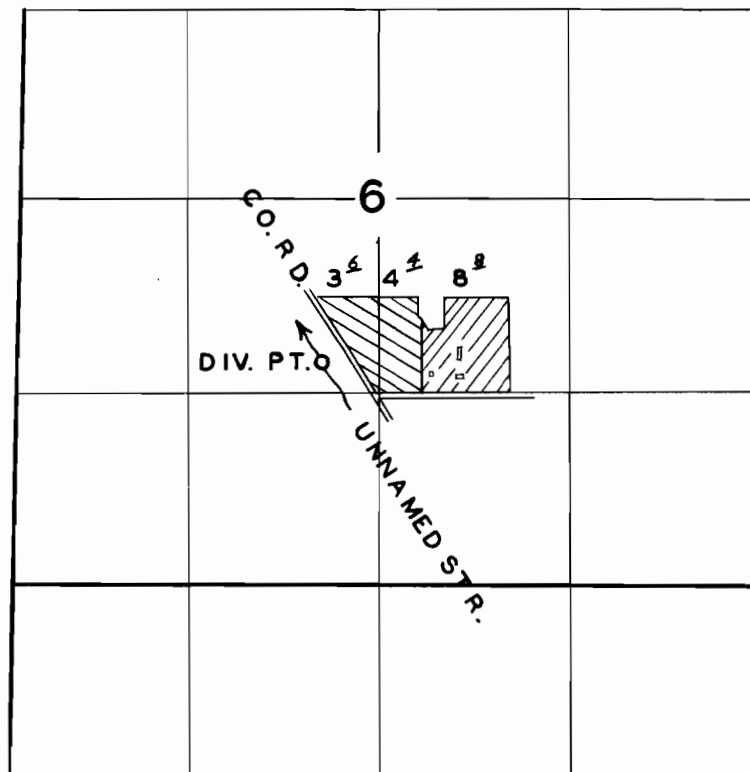


FINAL PROOF SURVEY

UNDER

25949

20334

 

Application No. 27126 Permit No. 21222



IN NAME OF

FRANK G. TYRELL

Surveyed AUG. 23 1956, by R. H. WHITBY

1956 V

PK9