
T. 2 N., R. 2W., W.M.

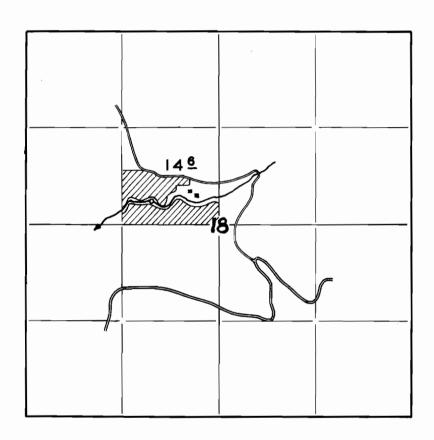

FINAL PROOF SURVEY

UNDER

Application No. 25839 Permit No. 20527 IN NAME OF

J. C. PARRISH

Surveyed 4 - 12 1956, by M. BISH