


T. 1 S., R. 1 W., W. M.

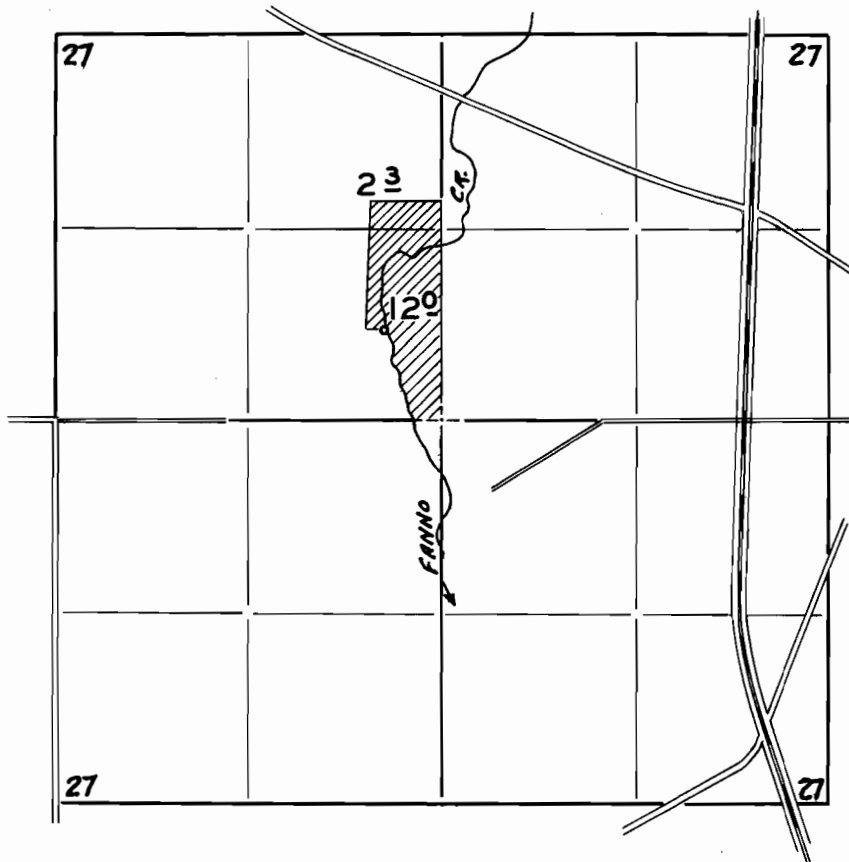

FINAL PROOF SURVEY

UNDER

Application No. 25906 Permit No. 20539

IN NAME OF

ROBERT B. MURPHY

Surveyed 4 - 16 1956, by M. BISH