


T.2S. R.1E. W.M.

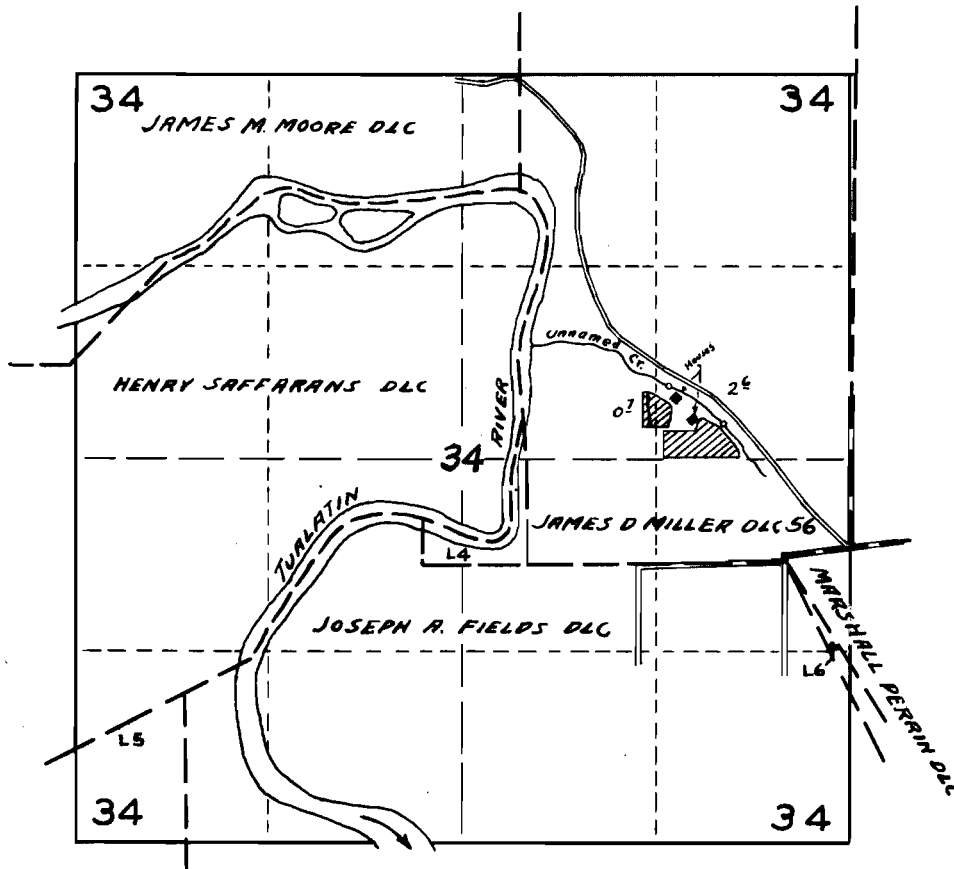

**FINAL PROOF SURVEY**

UNDER

Application No. 25944 Permit No. 20543  
IN NAME OF

ORVAL G. BUTLER

Surveyed 5 - 7 1956, by R.D. BEST