


T. 5&6S. R. 2W. W.M.

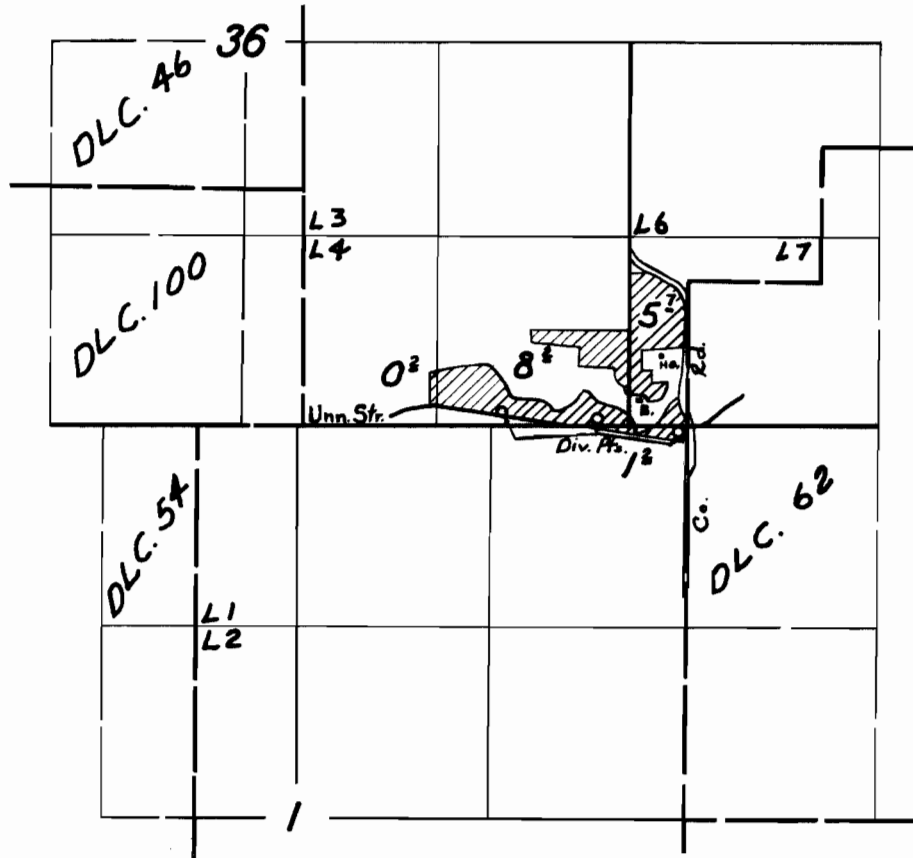

FINAL PROOF SURVEY

UNDER

Application No. 25979 Permit No. 20549

IN NAME OF

JOHN A. FERSCHWEILER

Surveyed 16 July 1956, by M. Bish

DFN-2D-105

Russ