


T. 2 N, R. 4 W., W.M.

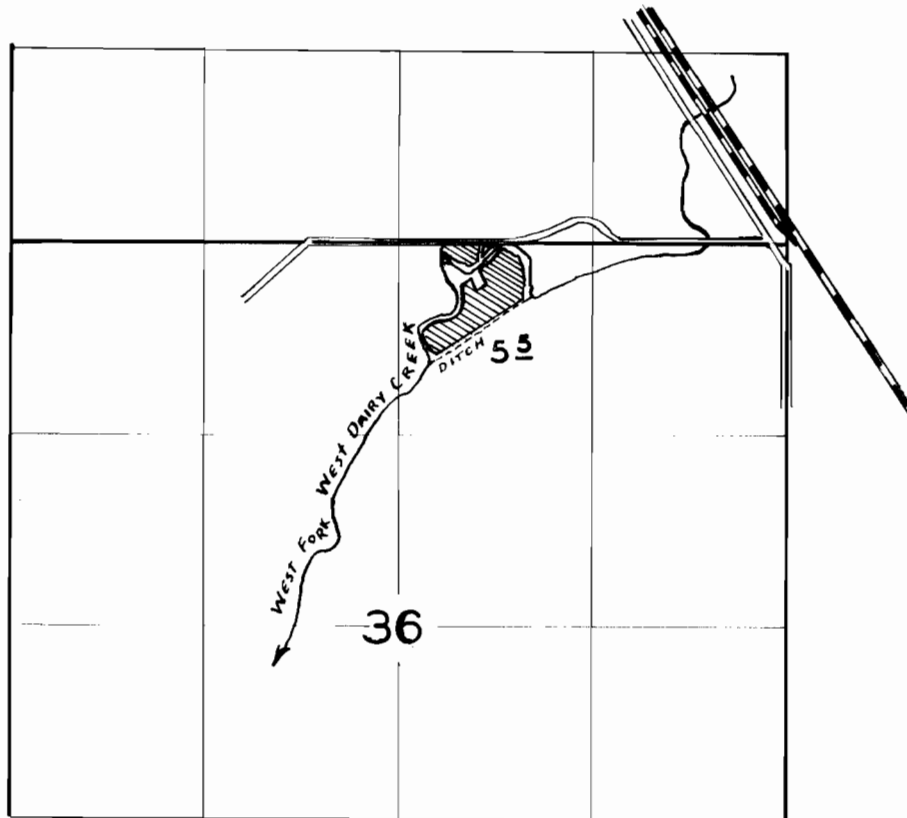

**FINAL PROOF SURVEY**

UNDER

Application No. 26097 Permit No. 20574

IN NAME OF

RAYMOND C. HUTCHISON

Surveyed 4 - 13 1956 by R.H. WHITBY