


T. 1 S. R. 3 W. W.M.

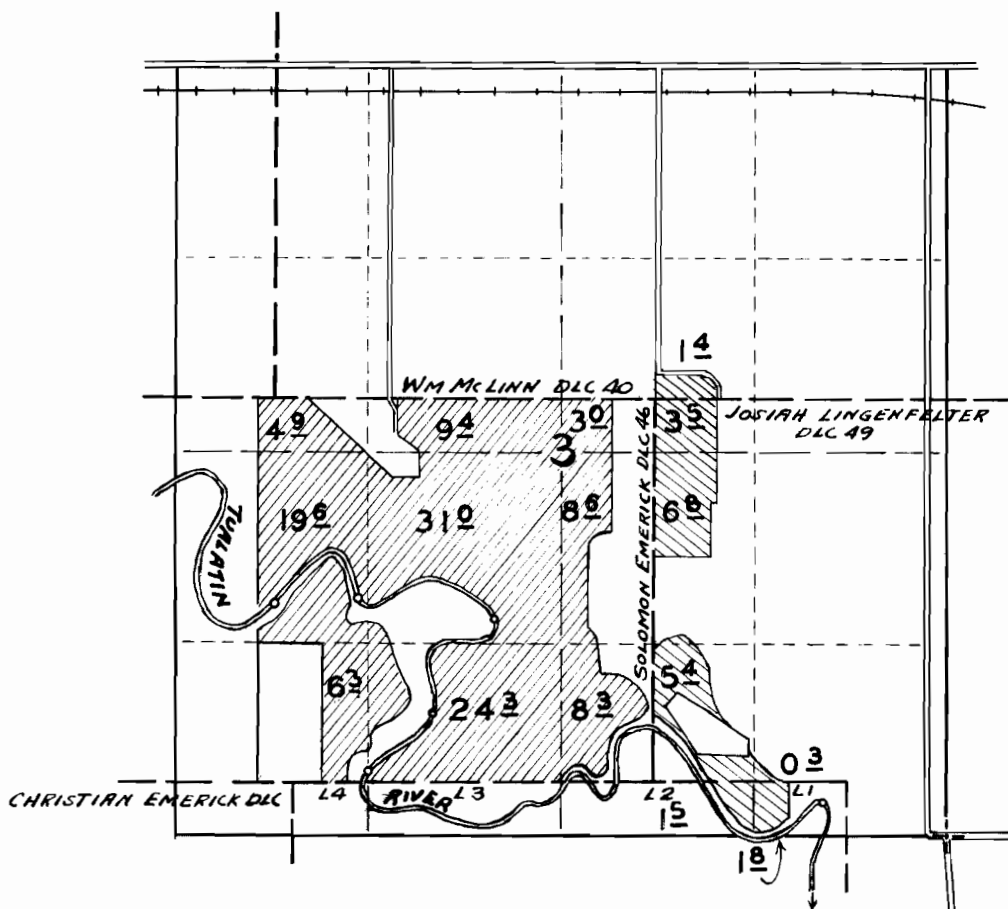

FINAL PROOF SURVEY

UNDER

26976

21189

Application No. 26203

Permit No. 20595



IN NAME OF

C. B. BUCHANAN, JR.

Surveyed 4-26 1956, by R. H. WHITBY.