


T. 2 N., R. 3 W., W.M.

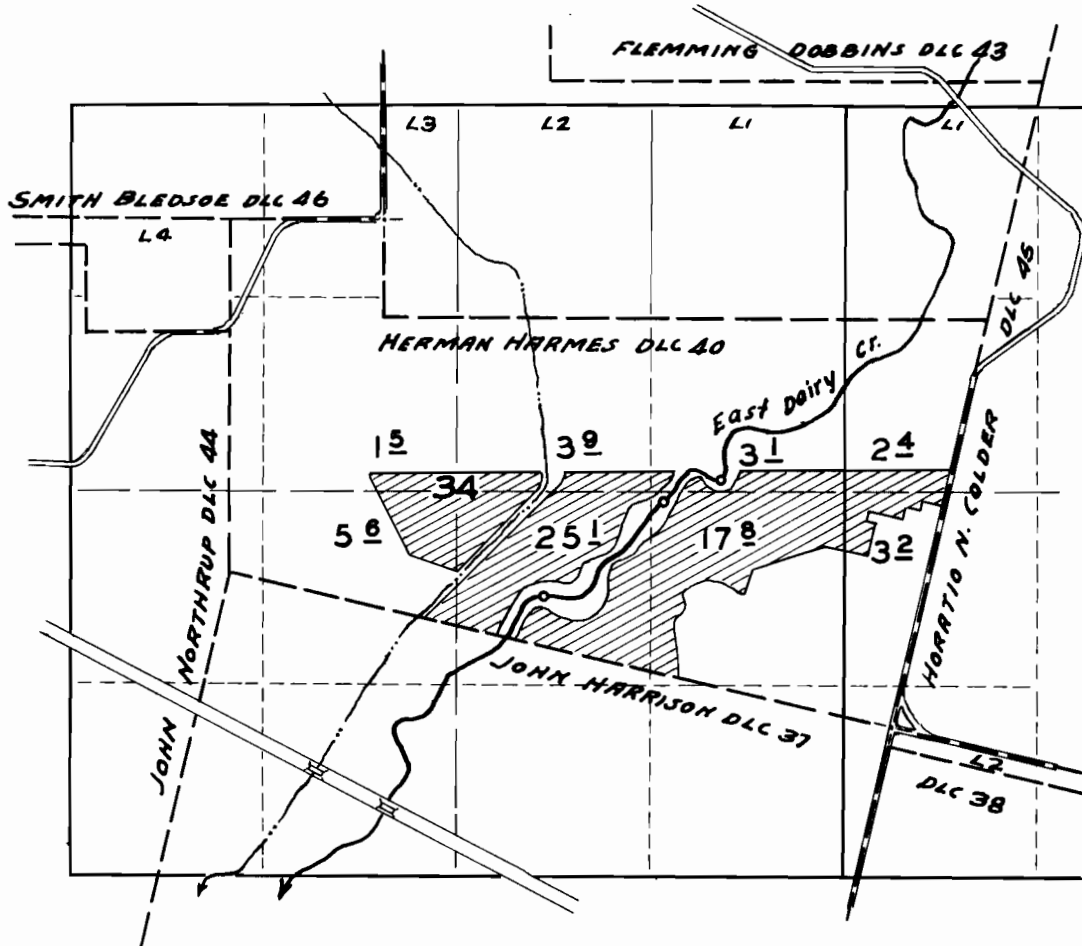

FINAL PROOF SURVEY

UNDER

Application No. 26217 Permit No. 20601

IN NAME OF

J. H. CROCKER

Surveyed 4 - 24 1956, by R. H. WHITBY.