


T.2S., R.2W., W.M.

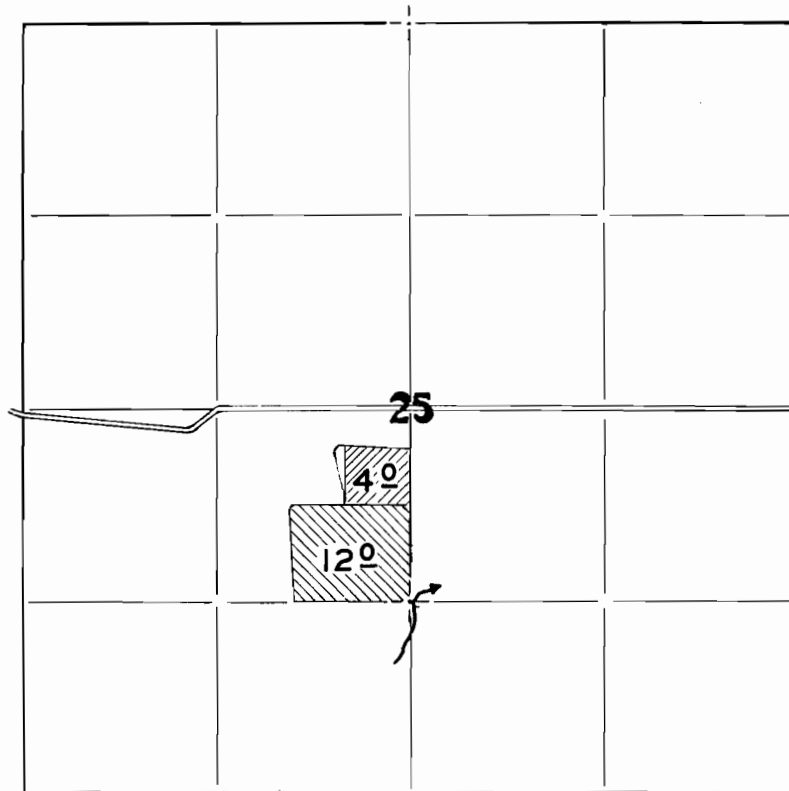

FINAL PROOF SURVEY

UNDER

28038

22117

Application No. 26308 Permit No. 20649

IN NAME OF

E. W. & RUTH M. REHWALT

Surveyed 4-27-1956, by M. BISH