


T. 4S. R. 1W. W.M.

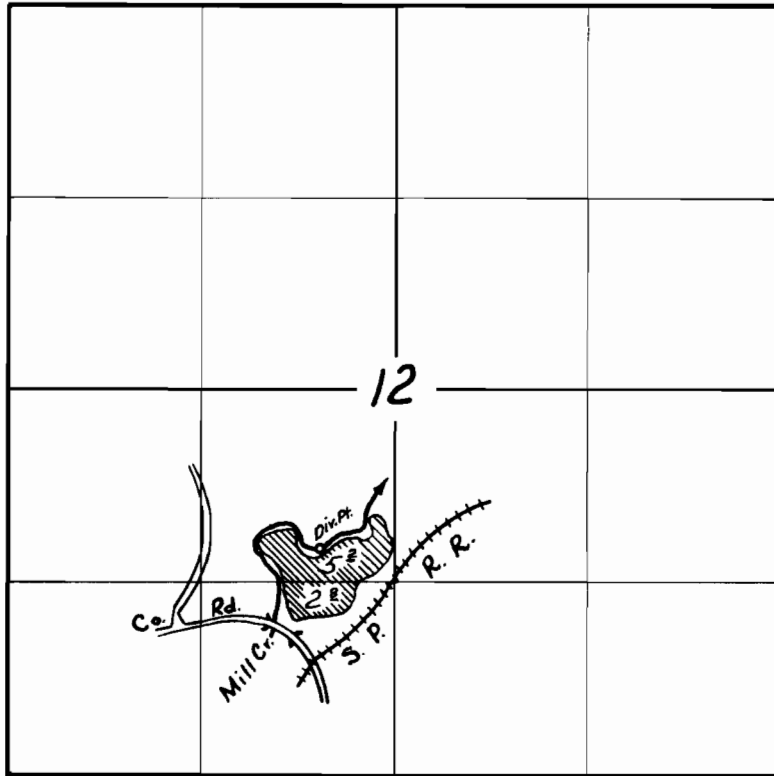

FINAL PROOF SURVEY

UNDER

Application No. 26398 Permit No. 20709

IN NAME OF

F. M. Ferguson

Surveyed 20 Sept 1956, by M. Bish

DFN-10-138

EWB