T. 1 S., R. 2 W., W.M.

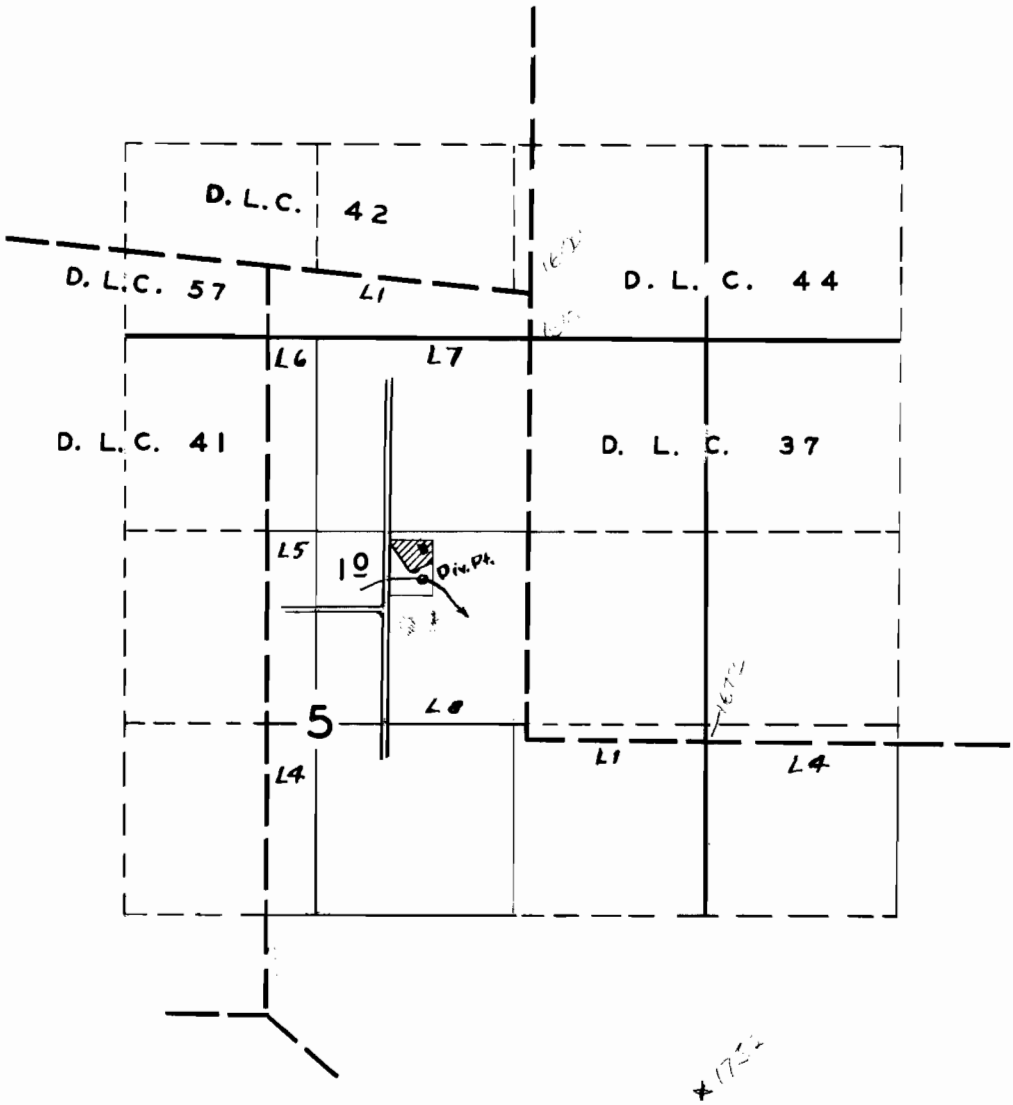

FINAL PROOF SURVEY

UNDER

Application No. 26444 Permit No. 20735

IN NAME OF

GORDON SAHNOW

Surveyed 4 - 24 1956, by M. BISH

1956 - J WC